



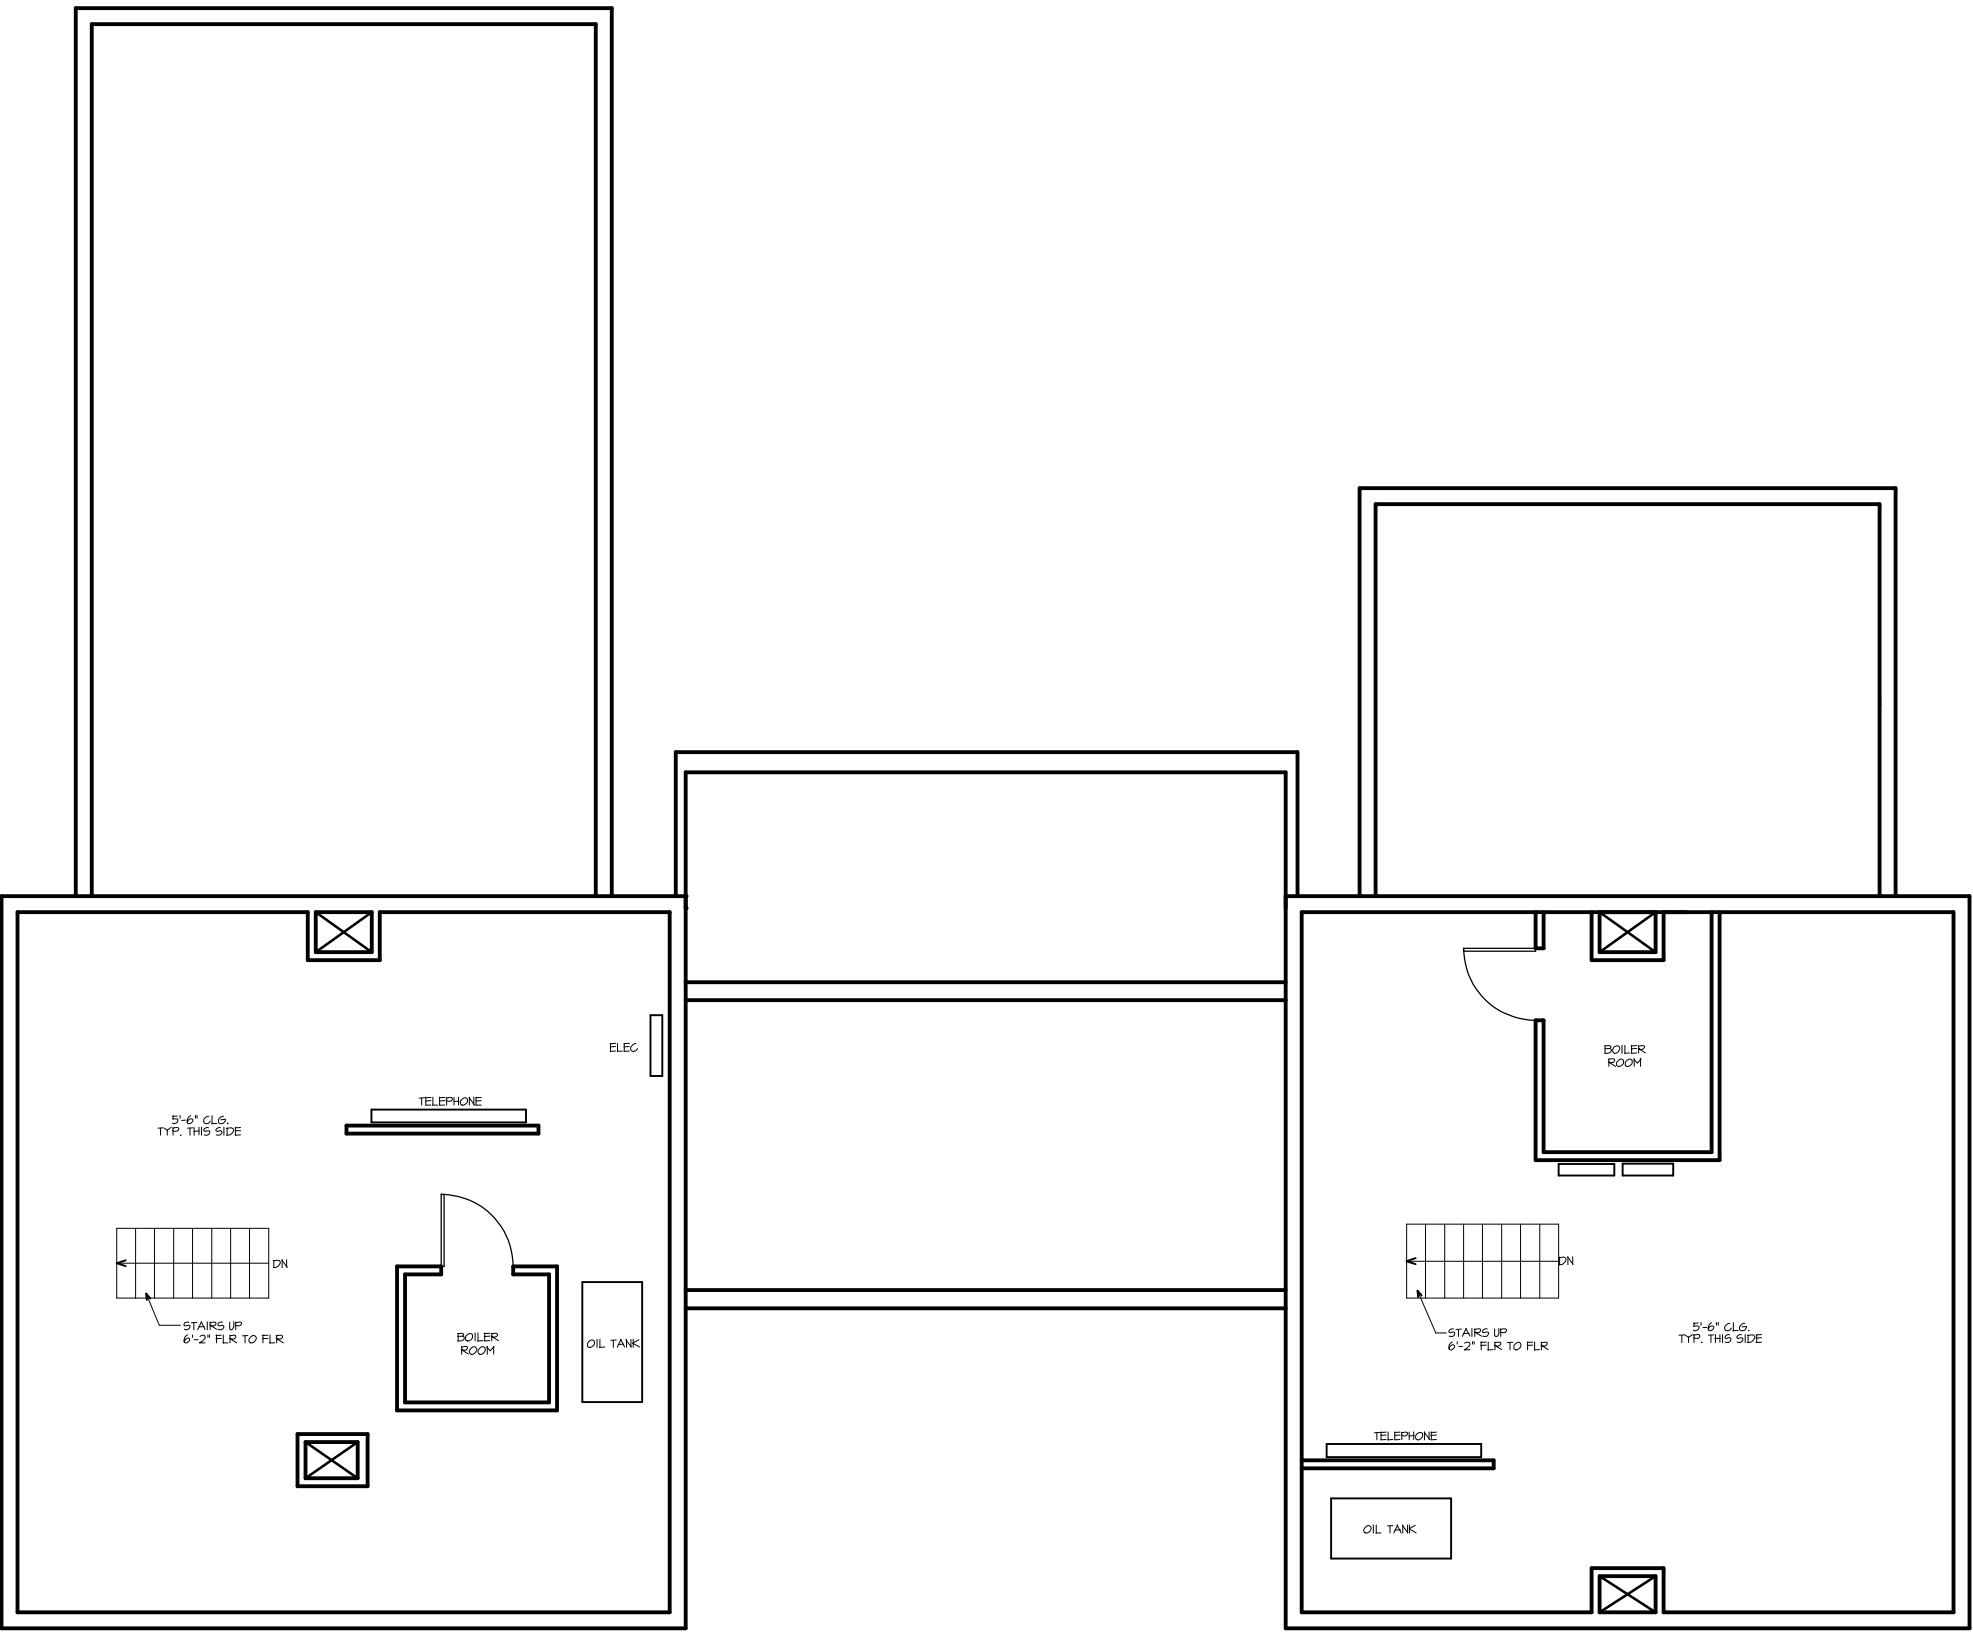

1
AB1.1

EXISTING BSMT. PLAN

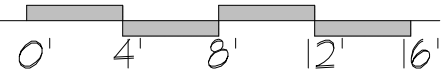

COWAN | GOUDREAU
ARCHITECTS, PLLC
5 Eagle Square
Concord, NH 03301
(603)-226-3990

COPYRIGHT © 2016
COWAN GOUDREAU ARCHITECTS, PLLC
NO RE-USE WITHOUT PERMISSION

Revisions:									

Issue Date:	7/12/2016
Plot Date:	8/19/2016
Design:	FDC
Drawn:	JK
Checked:	
Scale:	1/4"=1'-0"

PROJECT:

APPLIED GEO-SOLUTIONS
13 - 15 NEWMARKET ROAD
DURHAM, NH


Drawing Title:

EXISTING BSMT.
FLOOR PLAN

Drawing No:


AB1.1

APPLIED GEO-SOLUTIONS

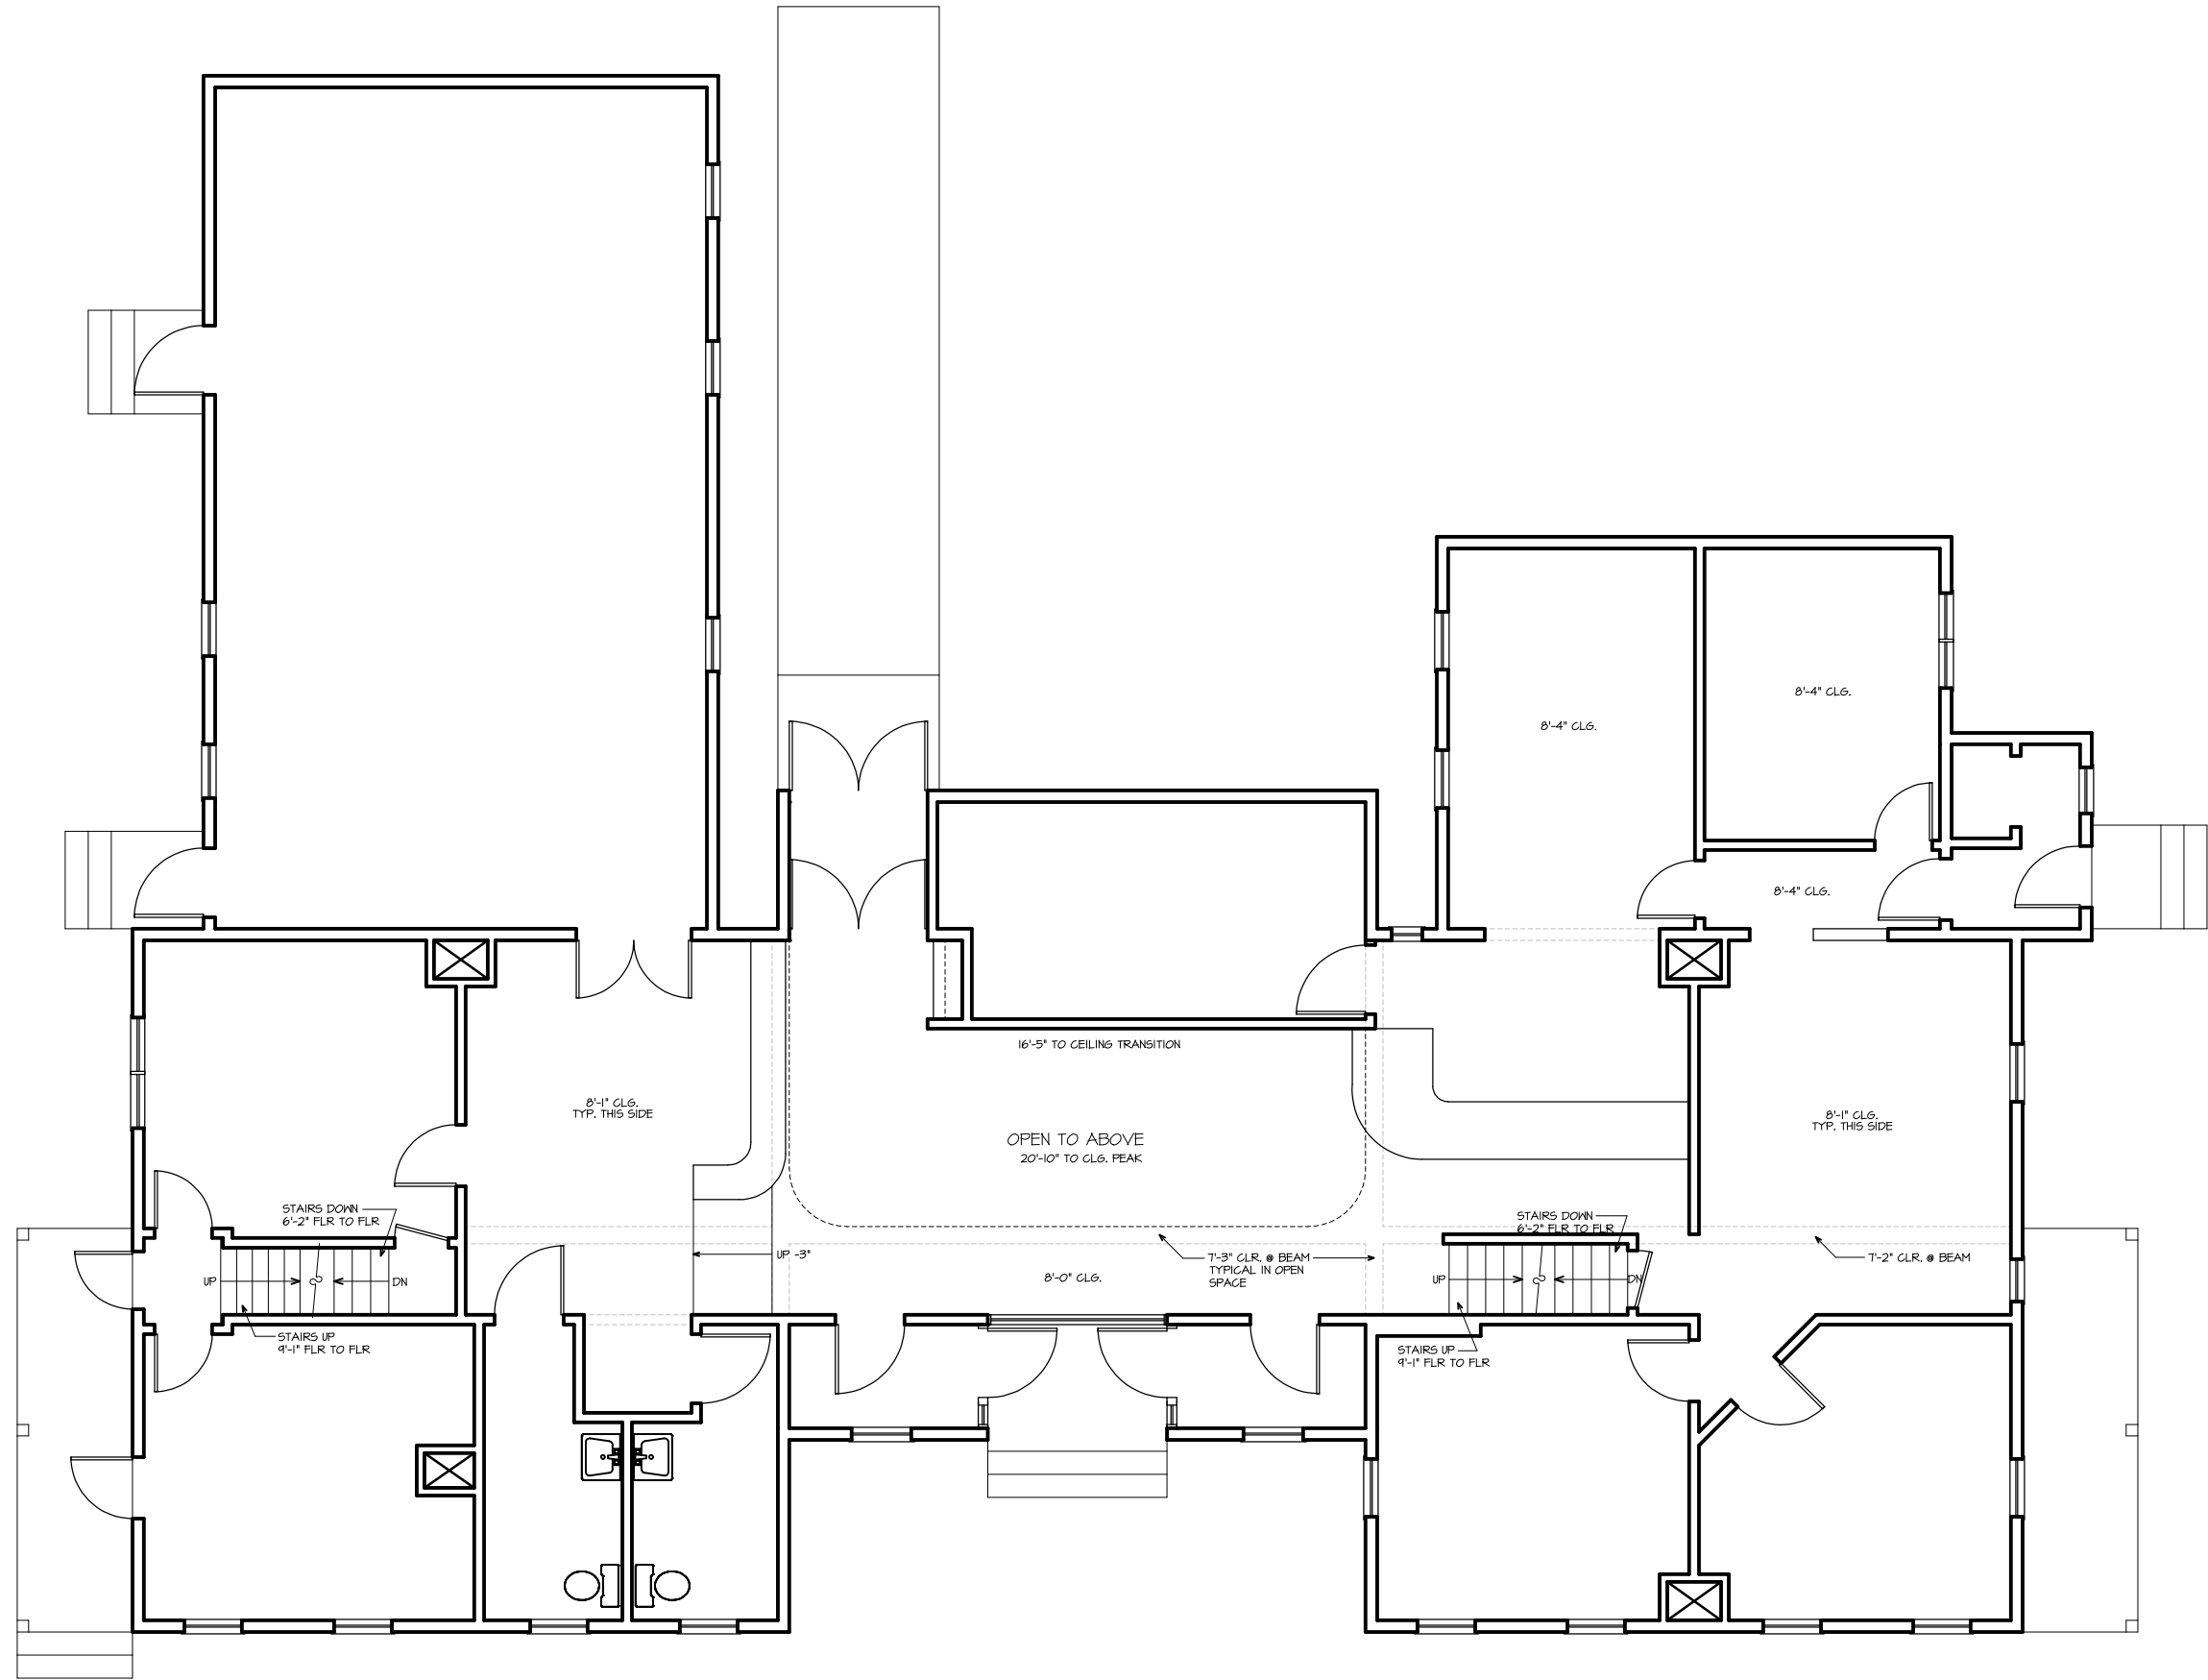

1
ABI.2

EXISTING 1ST FLOOR PLAN

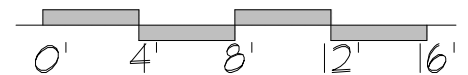

COWAN | GOUDREAU
ARCHITECTS, PLLC
5 Eagle Square
Concord, NH 03301
(603)-226-3990

COPYRIGHT © 2016
COWAN GOUDREAU ARCHITECTS, PLLC
NO REUSE WITHOUT PERMISSION

Revisions:

Issue Date:	7/12/2016
Plot Date:	8/19/2016
Design:	FDC
Drawn:	JK
Checked:	
Scale:	1/4"=1'-0"

PROJECT:

APPLIED GEO-SOLUTIONS
13-15 NEWMARKET ROAD
DURHAM, NH


Drawing Title:

EXISTING 1ST
FLOOR PLAN


Drawing No:

AB1.2

APPLIED GEO-SOLUTIONS

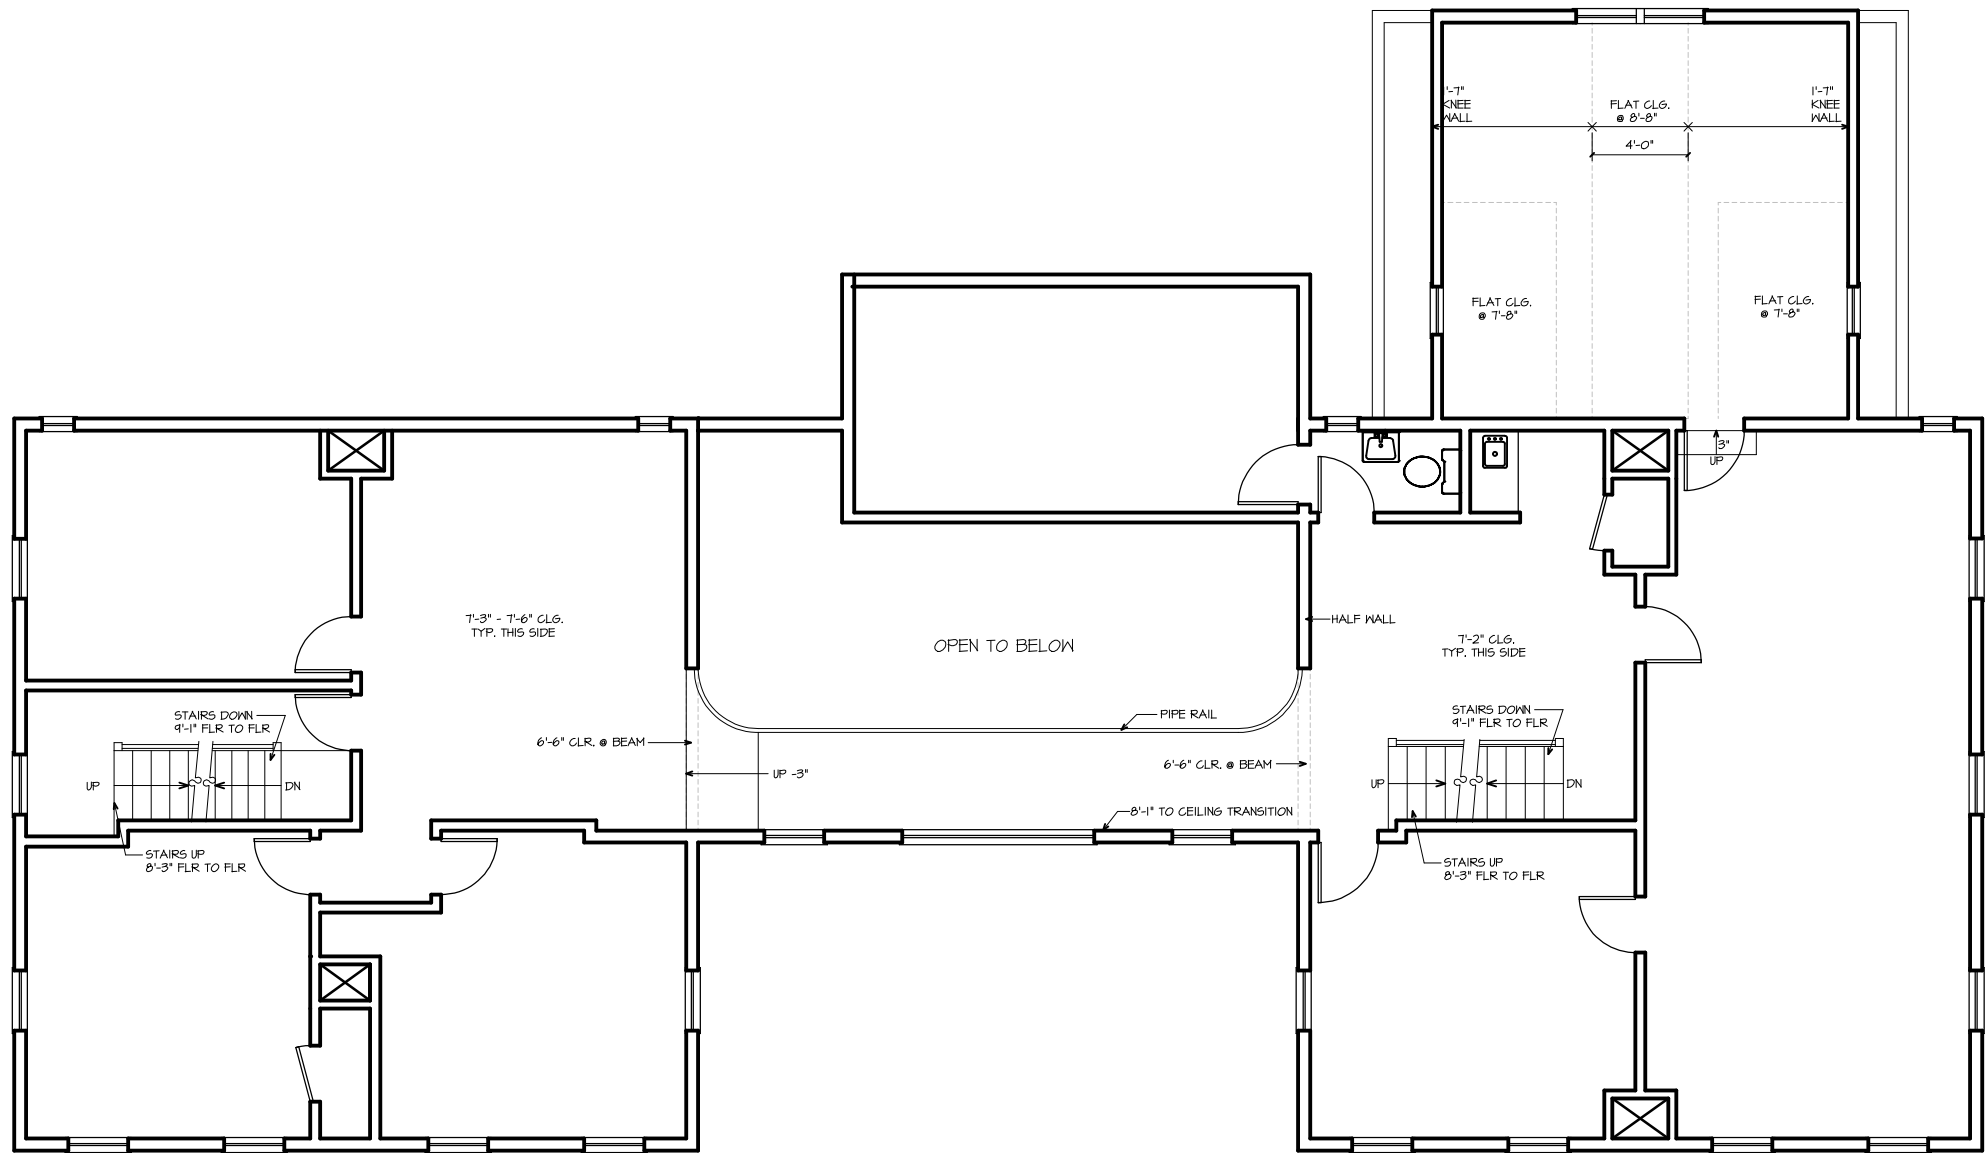

1 EXISTING 2ND FLOOR PLAN
ABI.3

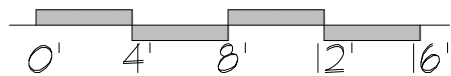

COWAN | GOUDREAU
ARCHITECTS, PLLC
5 Eagle Square
Concord, NH 03301
(603)-226-3990

COPYRIGHT © 2016
COWAN GOUDREAU ARCHITECTS, PLLC
NO REUSE WITHOUT PERMISSION

Revisions:

Issue Date:	7/12/2016
Plot Date:	8/19/2016
Design:	FDC
Drawn:	JK
Checked:	
Scale:	1/4"=1'-0"

PROJECT:

APPLIED GEO-SOLUTIONS
13-15 NEWMARKET ROAD
DURHAM, NH



Drawing Title:

EXISTING 2ND
FLOOR PLAN


Drawing No:

AB13

APPLIED GEO-SOLUTIONS

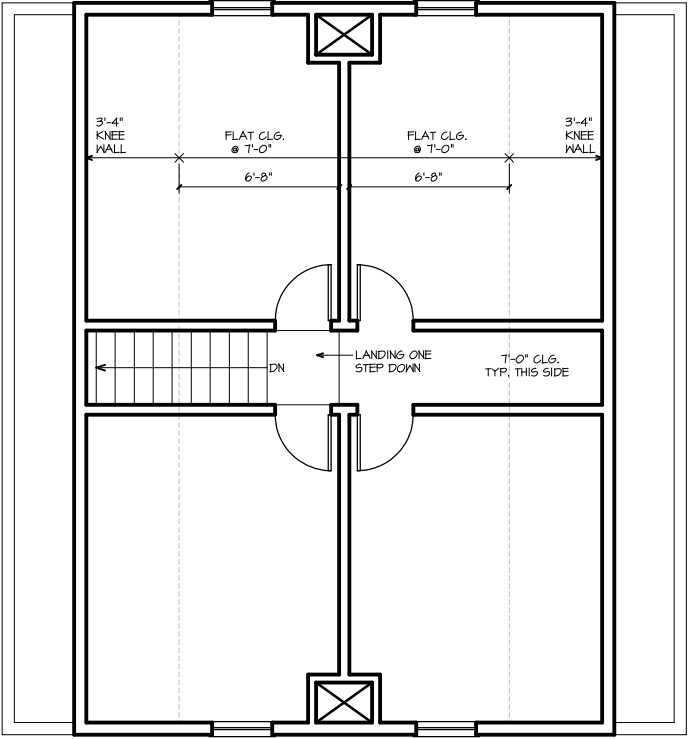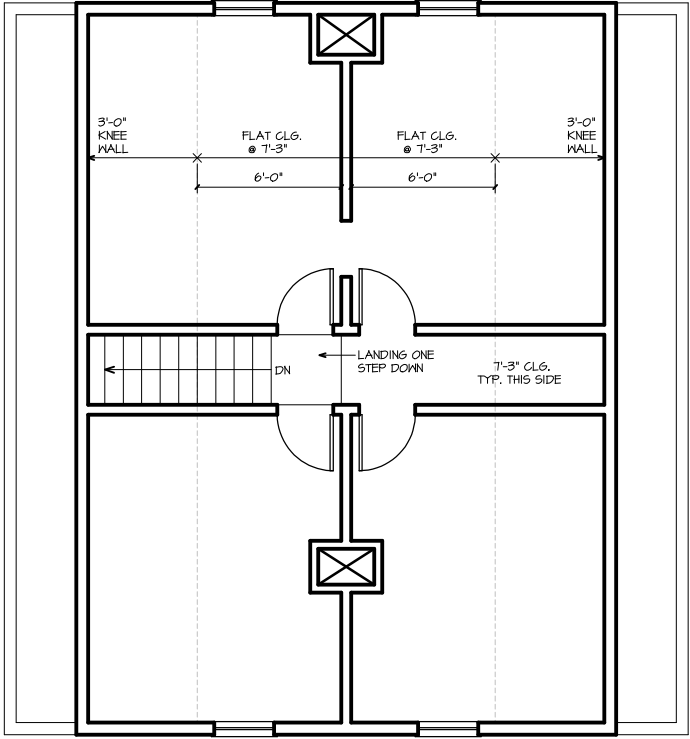

1 EXISTING ATTIC PLAN
ABI.4

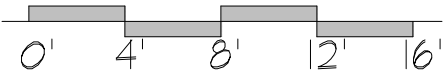




COWAN | GOUDREAU
ARCHITECTS, PLLC
5 Eagle Square
Concord, NH 03301
(603)-226-3990


COPYRIGHT © 2016
COWAN GOUDREAU ARCHITECTS, PLLC
NO RE-USE WITHOUT PERMISSION

Revisions:									
Issue Date:	7/12/2016	Plot Date:	8/19/2016	Design:	FDC	Drawn:	JK	Checked:	
									1/4" = 1'-0"
PROJECT:	APPLIED GEO - SOLUTIONS								
	13-15 NEWMARKET ROAD								
	DURHAM, NH								
Drawing Title:	EXISTING 3RD								
	FLOOR PLAN								
Drawing No:	ABI.4								
APPLIED GEO-SOLUTIONS									

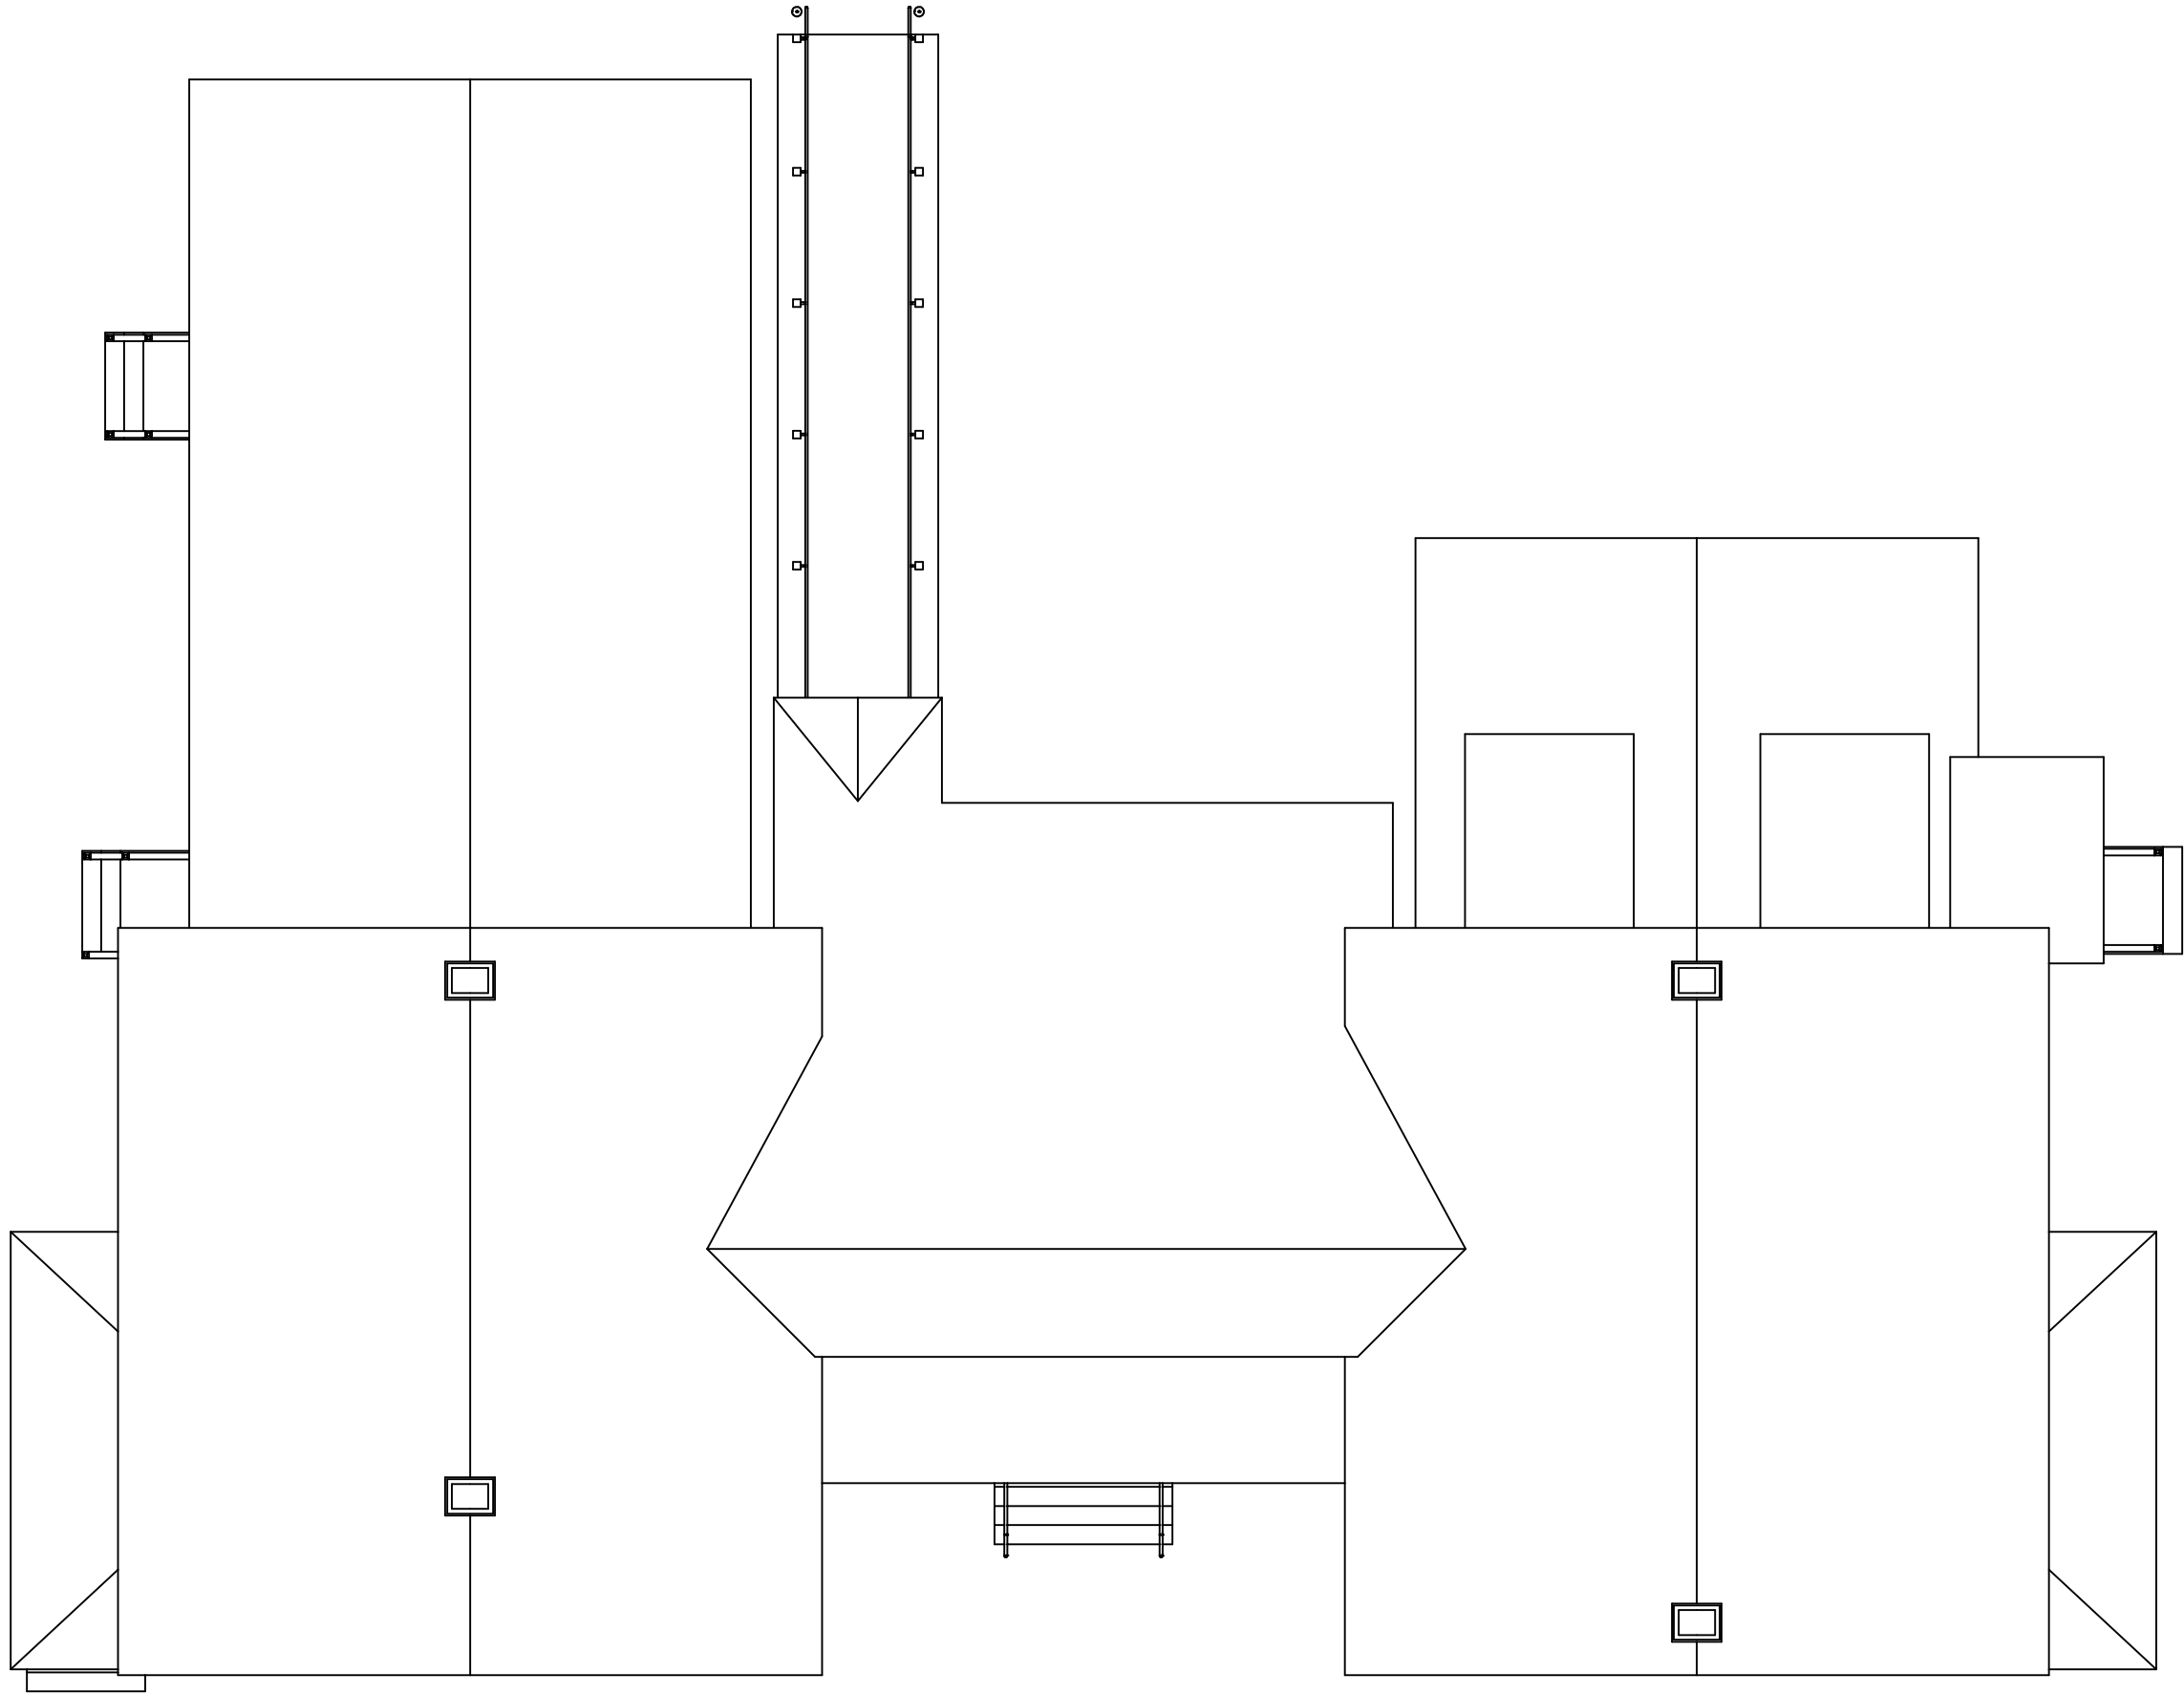

1
AB2.1

EXISTING ROOF PLAN

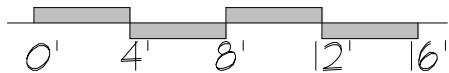

COWAN | GOUDREAU
ARCHITECTS, PLLC
5 Eagle Square
Concord, NH 03301
(603)-226-3990

COPYRIGHT © 2016
COWAN | GOUDREAU ARCHITECTS, PLLC
NO RE-USE WITHOUT PERMISSION

Revisions:

Issue Date:	7/12/2016
Plot Date:	8/19/2016
Design:	FDC
Drawn:	JK
Checked:	
Scale:	1/4" = 1'-0"

PROJECT:

APPLIED GEO-SOLUTIONS
13-15 NEWMARKET ROAD
DURHAM, NH

Drawing Title:

EXISTING ROOF
PLAN

Drawing No:

AB2.1


APPLIED GEO-SOLUTIONS



EXISTING SOUTH ELEVATION



2 EXISTING WEST ELEVATION
ABB.1

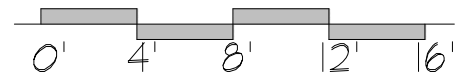

א

APPLIED GEO - SOLUTIONS
13 - 15 NEWMARKET ROAD
DURHAM, NH

EVICTING C

EXISTING
ELEVATIONS

ing

4B3.1


IED GEO-SOLUTIONS



1 EXISTING NORTH ELEVATION
AB3.2



2 EXISTING EAST ELEVATION
AB3.2

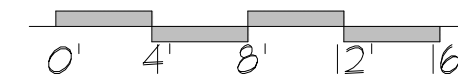

COWAN | GOUDREAU
ARCHITECTS, PLLC
5 Eagle Square
Concord, NH 03301
(603) 226-3990

COPYRIGHT © 2016
COWAN | GOUDREAU ARCHITECTS, PLLC
NO RE-USE WITHOUT PERMISSION

Revisions:

Issue Date:	7/12/2016
Plot Date:	8/19/2016
Design:	FDC
Drawn:	JK
Checked:	
Scale:	1/4" = 1'-0"

PROJECT:

APPLIED GEO-SOLUTIONS
13-15 NEWMARKET ROAD
DURHAM, NH

Drawing Title:

EXISTING
ELEVATIONS

Drawing No:

AB3.2

APPLIED GEO-SOLUTIONS



1 EXISTING ISOMETRIC DRAWINGS
NOT TO SCALE
AB4.1



COWAN | GOUDREAU
ARCHITECTS, PLLC
5 Eagle Square
Concord, NH 03301
(603) 226-3990

COPYRIGHT © 2016
COWAN | GOUDREAU ARCHITECTS, PLLC
NO REUSE WITHOUT PERMISSION

Revisions:

Issue Date:	7/12/2016
Plot Date:	8/19/2016
Design:	FDC
Drawn:	JK
Checked:	
Scale:	NOT TO SCALE

PROJECT:

APPLIED GEO-SOLUTIONS
13-15 NEWMARKET ROAD
DURHAM, NH

Drawing Title:

EXISTING ISOMETRIC
DRAWINGS

Drawing No:

AB4.1

APPLIED GEO-SOLUTIONS