

Key Map (1"=200')

LOT LINE
PER REF. PLAN #2




SHEET 1

SHEET 2


SHEET 3

SHEET 4

SHEET 5

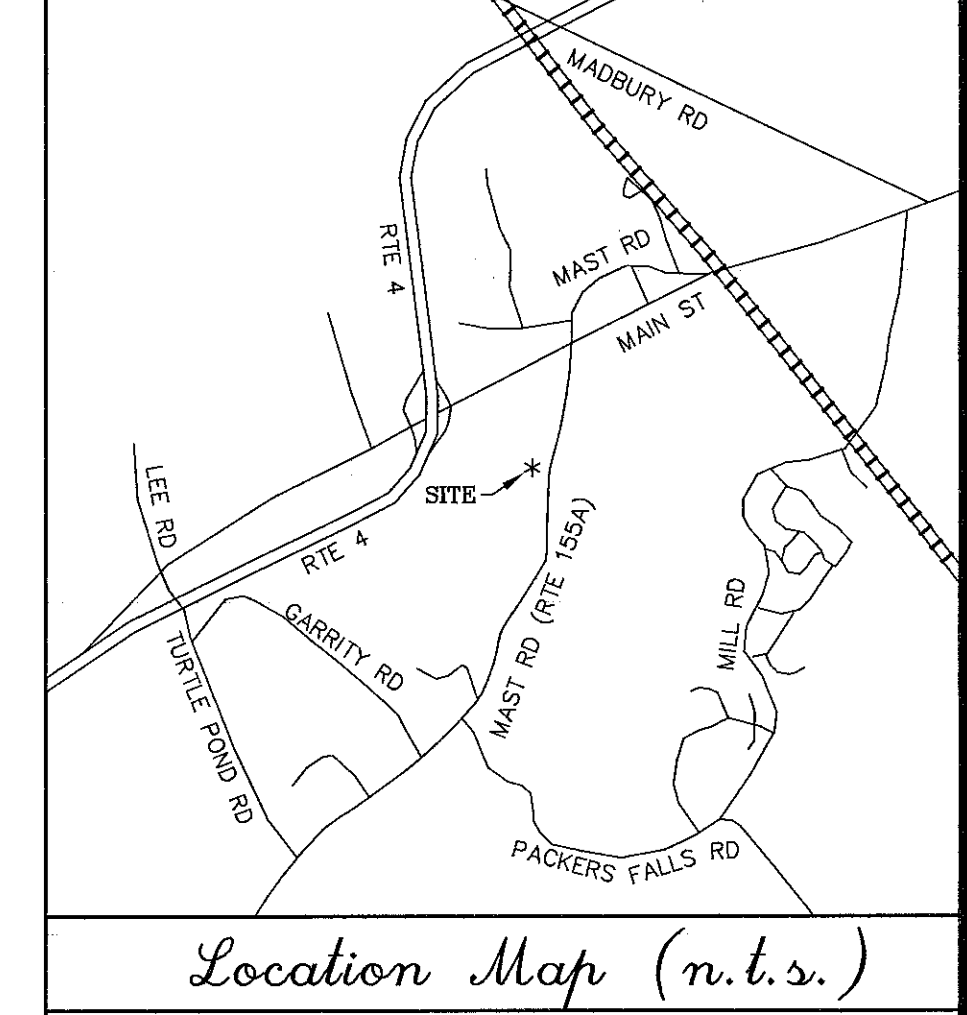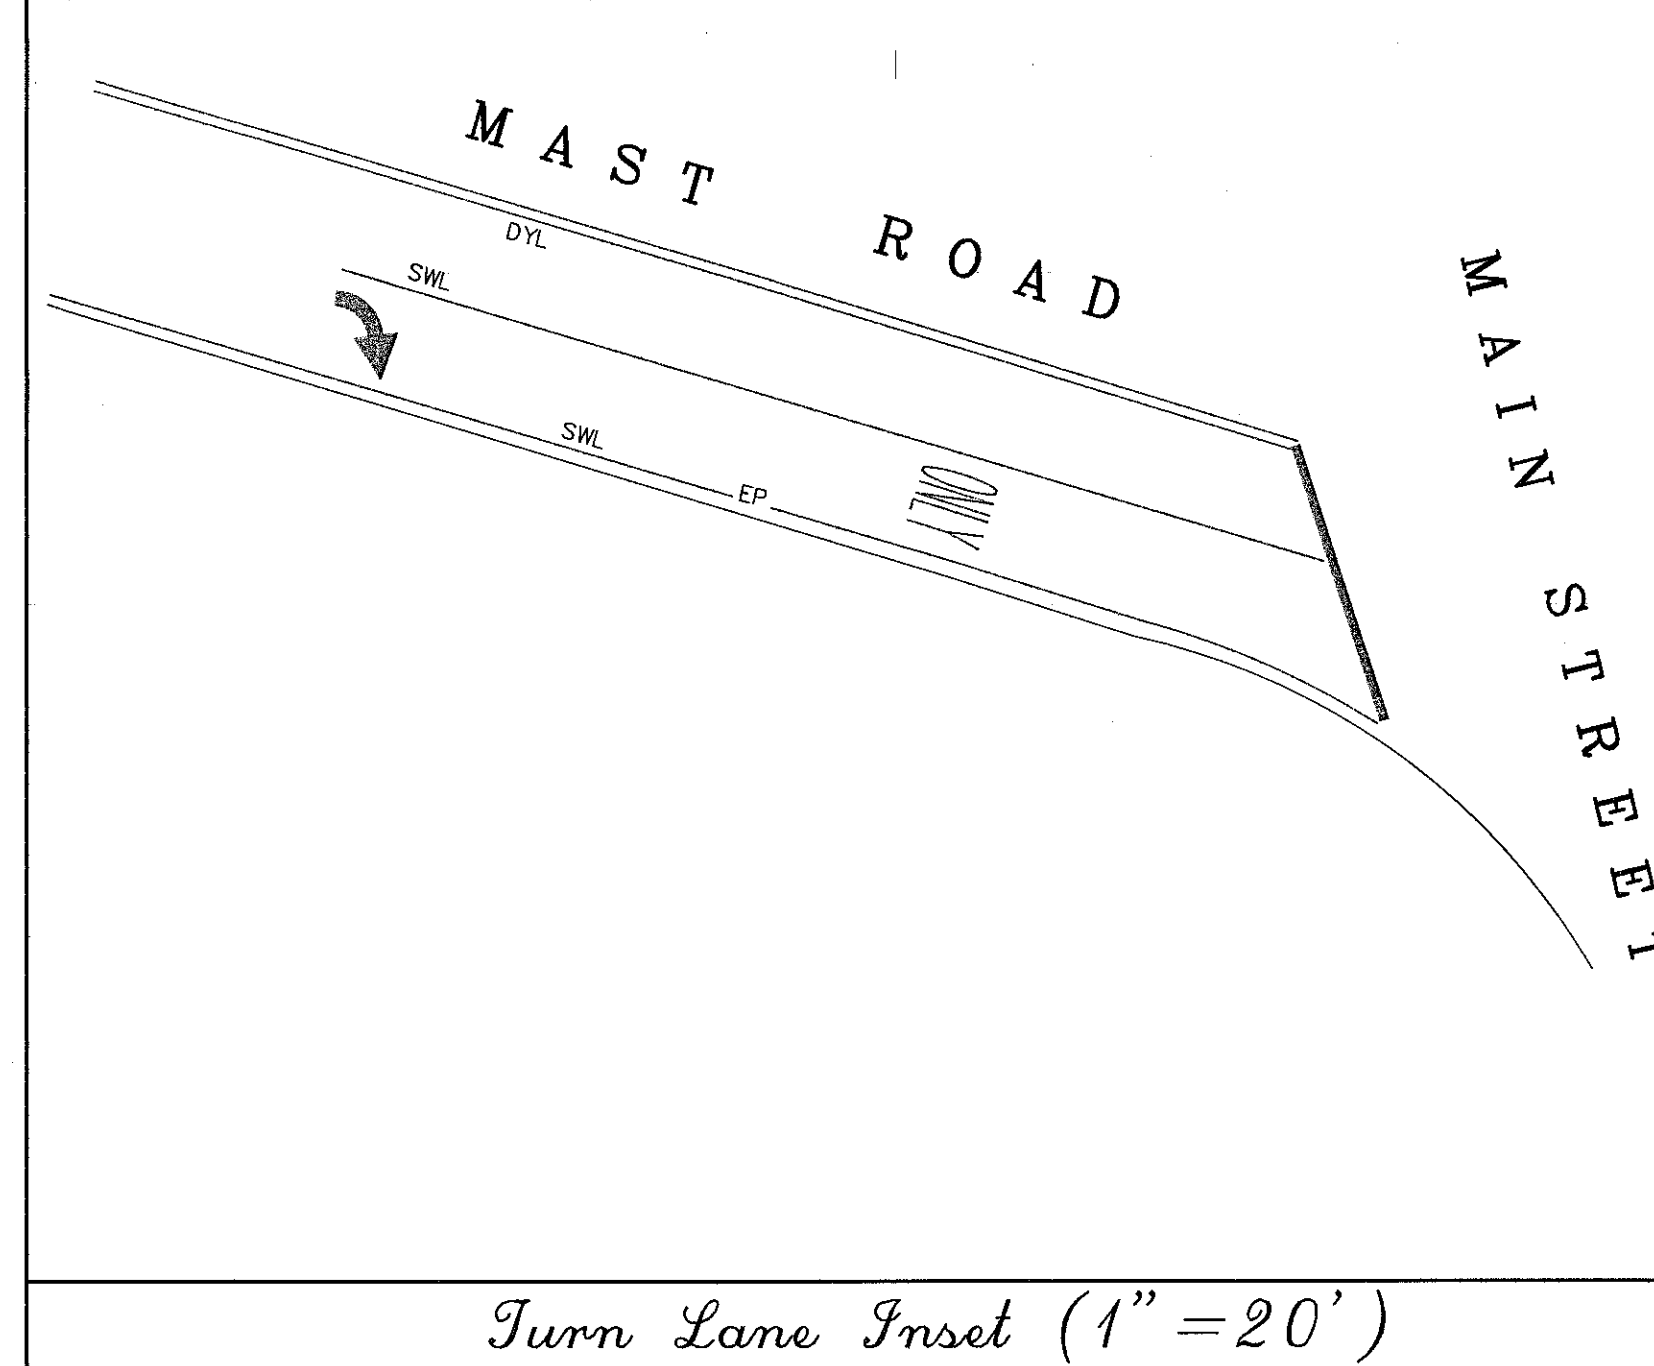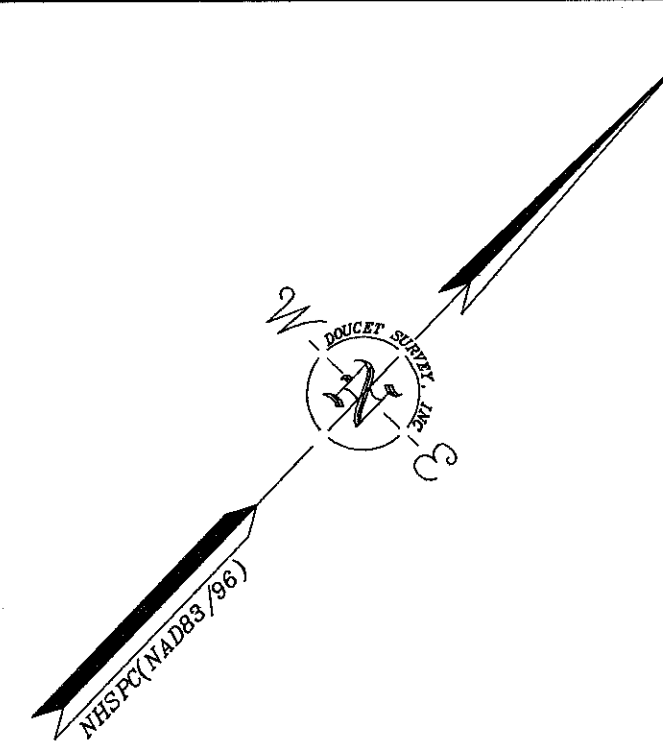

DRAINAGE TABLE		
DMH #2649 ELEV. = 103.2' RM ELEV. = 103.2' (A) 12" HDPE INV. = 96.9' (B) 18" HDPE INV. = 93.4' (C) 6" HDPE INV. = 98.2' (D) 18" HDPE INV. = 93.5'	CB #4455 ELEV. = 102.5' HOODED OUTLET WATER ELEV. = 97.9'	CB #6645 ELEV. = 100.9' HOODED OUTLET WATER ELEV. = 95.0'
CB #3187 ELEV. = 102.8' HOODED OUTLET WATER ELEV. = 97.5'	CBR #4525 ELEV. = 102.1' 12" PVC INV. = 97.8'	DMH #6657 ELEV. = 101.8' (A) 12" HDPE INV. = 94.5' (B) 12" HDPE INV. = 94.6' (C) 12" HDPE INV. = 94.7' (D) 12" HDPE INV. = 94.6'
DMH #3188 ELEV. = 103.1' (A) 12" HDPE INV. = 97.1' (B) 12" HDPE INV. = 94.4' (C) 12" HDPE INV. = 97.4'	CBR #4528 ELEV. = 102.5' 12" PVC INV. = 97.7'	CB #6948 ELEV. = 101.9' HOODED OUTLET WATER ELEV. = 96.8'
CB #3215 ELEV. = 102.7' HOODED OUTLET WATER ELEV. = 97.6'	DMH #4722 ELEV. = 102' (A) 18" HDPE INV. = 93.9' (B) 12" HDPE INV. = 96.3' (C) 12" HDPE INV. = 96.7' (D) 12" HDPE INV. = 94.1'	DMH #6949 ELEV. = 102.5' (A) 12" HDPE INV. = 95.4' (B) 12" HDPE INV. = 95.5' (C) 12" HDPE INV. = 96.5'
DMH #3217 ELEV. = 104' (A) 24" HDPE INV. = 92.5' (B) 12" HDPE INV. = 96.6' (C) 18" HDPE INV. = 92.2'	CB #7425 ELEV. = 101.5' HOODED OUTLET WATER ELEV. = 96.6'	CBR #7184 ELEV. = 103.9' (SILT BAG IN PLACE)
DMH #3447 ELEV. = 92.6' (A) 24" HDPE INV. = 89.1' (B) 24" HDPE INV. = 88.9'	CB #7476 ELEV. = 102.7' HOODED OUTLET WATER ELEV. = 97.7'	CBR #7252 ELEV. = 102.8' 12" PVC INV. = 97.6'
DMH #3553 ELEV. = 98.1' (A) 24" HDPE INV. = 89.6' (B) 12" HDPE INV. = 90.5' (C) 24" HDPE INV. = 90.2'	DMH #4754 ELEV. = 102.6' (A) 12" HDPE INV. = 97.1' (B) 12" HDPE INV. = 97.4' (C) 12" HDPE INV. = 97.4' (D) 12" HDPE INV. = 97.4'	DMH #7321 ELEV. = 103.2' (A) 12" HDPE INV. = 96.0' (B) 12" HDPE INV. = 97.3' (C) 12" HDPE INV. = 96.0'
CB #3630 ELEV. = 99.4' HOODED OUTLET WATER ELEV. = 94.4'	DMH #4852 ELEV. = 102.7' (A) 12" HDPE INV. = 97.8' (B) 12" HDPE INV. = 97.7'	CBR #7322 ELEV. = 102.7' HOODED OUTLET WATER ELEV. = 97.5'
DMH #3635 ELEV. = 98.8' (A) 24" HDPE INV. = 90.6' (B) 12" HDPE INV. = 94.1' (C) 24" HDPE INV. = 90.5'	CBR #4856 ELEV. = 103.5' (A) 12" PVC INV. = 98.5' (B) 12" PVC INV. = 98.5'	DMH #7345 ELEV. = 101.9' (A) 12" HDPE INV. = 96.7' (B) 12" HDPE INV. = 96.7' (C) 12" HDPE INV. = 96.7'
CB #3645 ELEV. = 97.8' HOODED OUTLET WATER ELEV. = 91.3'	DMH #5275 ELEV. = 102.4' (A) 18" HDPE INV. = 93.1' (B) 18" HDPE INV. = 93.2' (C) 12" HDPE INV. = 97.0'	CB #7346 ELEV. = 101.4' (SILT BAG IN PLACE)
DMH #3795 ELEV. = 102.5' (A) 24" HDPE INV. = 91.8' (B) 12" HDPE INV. = 97.4' (C) 24" HDPE INV. = 91.7' (D) 12" HDPE INV. = 97.7' (E) 12" HDPE INV. = 96.8'	CB #5276 ELEV. = 102' HOODED OUTLET WATER ELEV. = 97.2'	DMH #7454 ELEV. = 103.7' (A) 18" HDPE INV. = 94.3' (B) 12" HDPE INV. = 98.6' (C) 18" HDPE INV. = 94.4'
CB #3799 ELEV. = 100.9' HOODED OUTLET WATER ELEV. = 96.1'	CB #5282 ELEV. = 102.1' HOODED OUTLET WATER ELEV. = 97.1'	CB #7555 ELEV. = 100.2' (SILT BAG IN PLACE)
DMH #3805 ELEV. = 101.7' (A) 24" HDPE INV. = 91.1' (B) 12" HDPE INV. = 96.1' (C) 24" HDPE INV. = 91.8' (D) 12" HDPE INV. = 96.1' (E) 15" HDPE INV. = 92.3'	CB #5291 ELEV. = 103.3' HOODED OUTLET WATER ELEV. = 98.0'	CB #7577 ELEV. = 100.5' (A) 12" HDPE INV. = 92.8' (B) 12" HDPE INV. = 92.9'
CB #3858 ELEV. = 100.3' (PARKED OVER)	DMH #5649 ELEV. = 103.5' (A) 18" HDPE INV. = 93.9' (B) 18" HDPE INV. = 93.9' (C) 12" HDPE INV. = 98.0'	CB #7587 ELEV. = 101.7' HOODED OUTLET WATER ELEV. = 96.7'
DMH #3879 ELEV. = 101.4' (A) 18" HDPE INV. = 93.5' (B) 12" HDPE INV. = 93.5' (C) 6" HDPE INV. = 96.6' (D) 12" HDPE INV. = 94.7' (E) 6" HDPE INV. = 98.6'	CB #5723 ELEV. = 103.3' HOODED OUTLET WATER ELEV. = 98.7'	CB #7589 ELEV. = 101.9' HOODED OUTLET WATER ELEV. = 96.7'
CB #3913 ELEV. = 101' HOODED OUTLET WATER ELEV. = 95.9'	DMH #5724 ELEV. = 103.7' (A) 18" HDPE INV. = 94.7' (B) 18" HDPE INV. = 94.6' (C) 12" HDPE INV. = 98.5'	CBR #7653 ELEV. = 101.2' (SILT BAG IN PLACE)
CB #4443 ELEV. = 102.4' HOODED OUTLET WATER ELEV. = 96.0'	CB #5733 ELEV. = 103.6' HOODED OUTLET WATER ELEV. = 98.8'	CBR #8017 ELEV. = 104.1' (SILT BAG IN PLACE)
	CB #5915 ELEV. = 103.4' HOODED OUTLET WATER ELEV. = 98.7'	CBR #8019 ELEV. = 105.1' (SILT BAG IN PLACE)
	DMH #5916 ELEV. = 103.9' (A) 18" HDPE INV. = 95.4' (B) 12" HDPE INV. = 95.2' (C) 12" HDPE INV. = 95.5'	DMH #8143 ELEV. = 102.2' (A) 12" HDPE INV. = 96.4' (B) 12" HDPE INV. = 96.4' (C) 12" HDPE INV. = 96.4'

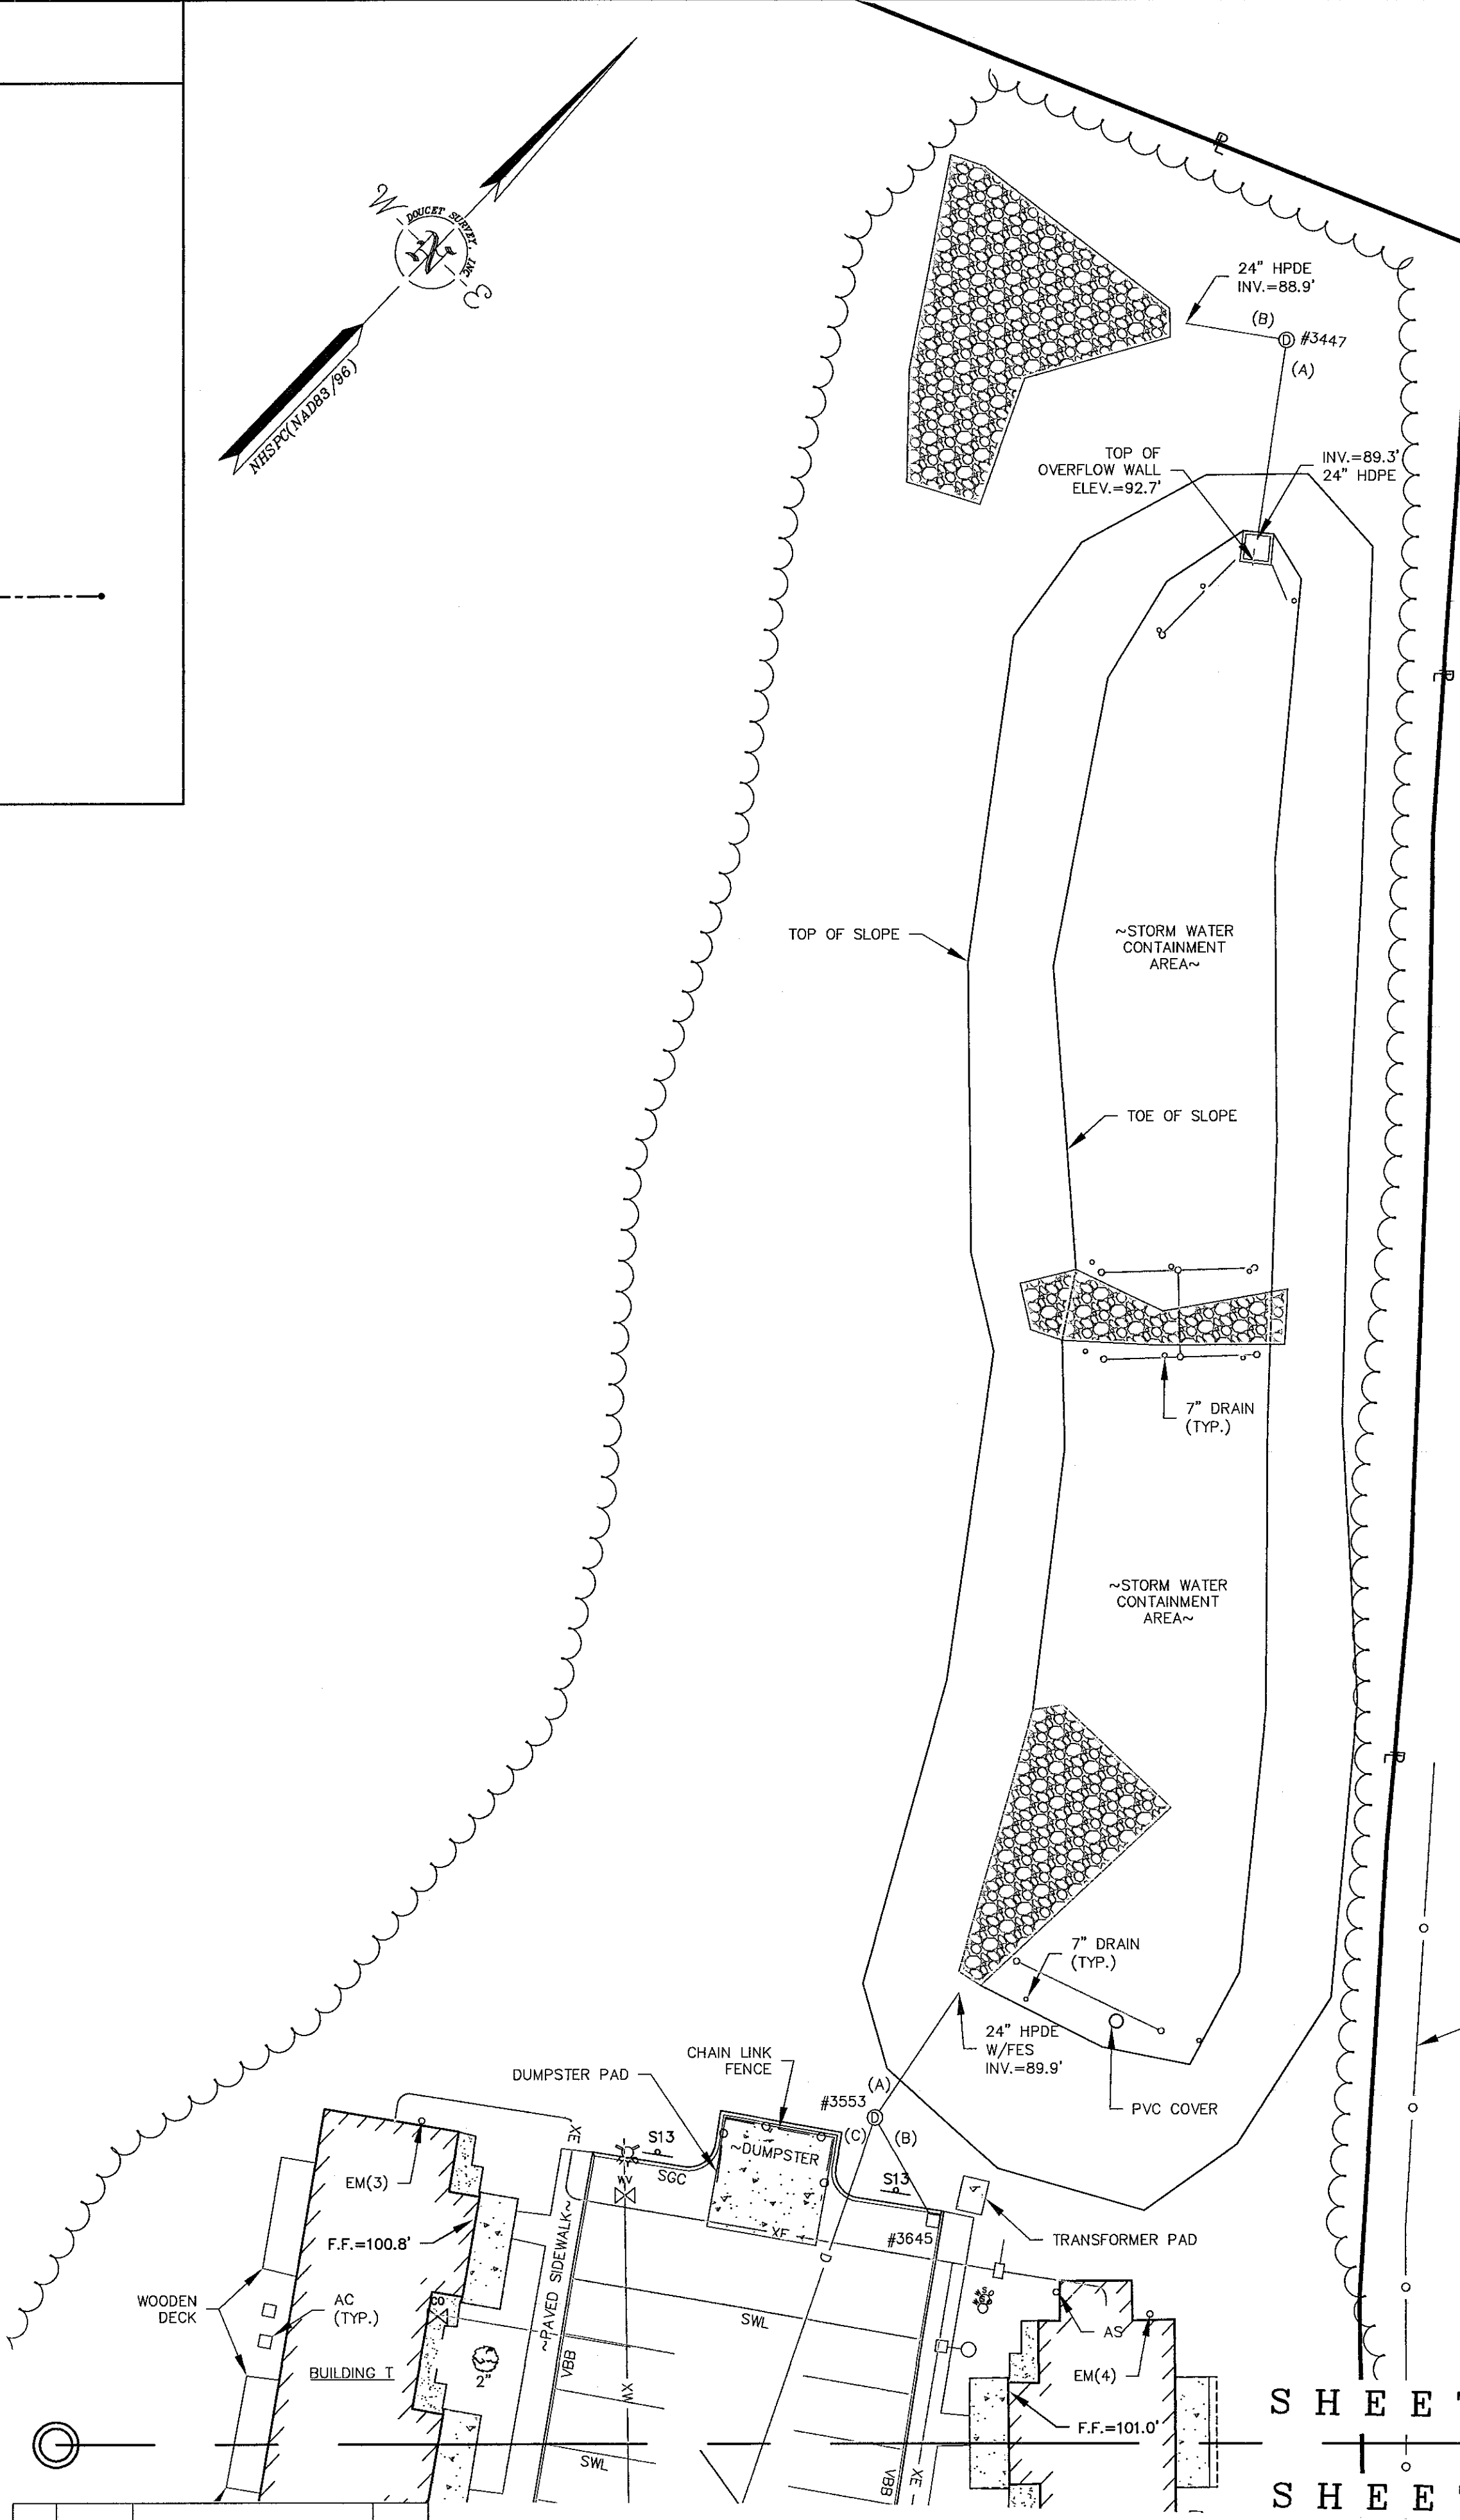

SWER TABLE

SMH #2870
ELEV. = 102.1"
(A) 8" PVC INV. = 87.7"
(B) 8" PVC INV. = 87.8"

SMH #2887
ELEV. = 101.4"
(A) 8" PVC INV. = 86.9"
(B) 12" PVC INV. = 88.4"
(C) 12" PVC INV. = 86.8"

SMH #3216
ELEV. = 104"
(A) 8" PVC INV. = 88.4"
(B) 8" PVC INV. = 89.3"
(C) 6" PVC INV. = 89.0"

SMH #3636
ELEV. = 99.2"
(A) 8" PVC INV. = 91.9"
(B) 4" PVC INV. = 92.2"

SMH #3811
ELEV. = 101.2"
(A) 8" PVC INV. = 89.0"
(B) 8" PVC INV. = 89.2"
(C) 8" PVC INV. = 91.4"

SMH #3870
ELEV. = 101.8"
(A) 8" PVC INV. = 90.5"
(B) 6" PVC INV. = 92.2"

SMH #5368
ELEV. = 102.6"
(A) 8" PVC INV. = 89.0"
(B) 8" PVC INV. = 89.0"

SMH #5595
ELEV. = 103.7"
(A) 8" PVC INV. = 89.5"
(B) 8" PVC INV. = 89.5"

SMH #5725
ELEV. = 104.2"
(A) 8" PVC INV. = 91.5"
(B) 8" PVC INV. = 91.5"









SMH #6651
ELEV. 101.4"
(A) 8" PVC INV. = 92.8"
(B) 8" PVC INV. = 92.8"

SMH #6697
ELEV. = 102.9"
(A) 8" PVC INV. = 93.2"
(B) 8" PVC INV. = 95.7"

SMH #7320
ELEV. = 104.4"
(A) 8" PVC INV. = 92.8"
(B) 8" PVC INV. = 92.8"
(C) 8" PVC INV. = 92.8"

SMH #7554
ELEV. = 100.9"
(A) 8" PVC INV. = 93.7"
(B) 4" PVC INV. = 93.7"

SMH #7913
ELEV. 104.1"
(A) 8" PVC INV. = 97.0"
(B) 6" PVC INV. = 97.0"

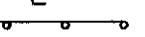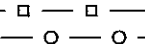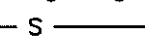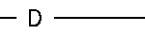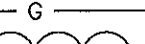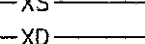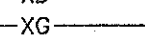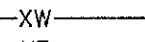
LEGEND	
	UTILITY POLE & GUY WIRE
	LIGHT POLE
	LIGHT POLE (ONE ARM)
	SIGN
	FIRE HYDRANT
	GAS GATE VALVE
	PRESSURE INDICATOR VALVE
	WATER GATE VALVE
	WATER SHUTOFF VALVE
	CLEANOUT
	IRRIGATION CONTROL VALVE
	ELECTRIC BOX
	TELECOMMUNICATION BOX
	UTILITY BOX
	CATCH BASIN (ROUND)
	CATCH BASIN
	DRAIN MANHOLE
	SEWER MANHOLE
	MANHOLE
	CONIFEROUS TREE
	DECIDUOUS TREE
	CONCRETE
	RIP RAP
	LANDSCAPED AREA
	CRUSHED STONE
	HANDICAP PARKING SPACE
	BOLLARD
	TRAFFIC FLOW DIRECTION ARROW
TYP.	TYPICAL
RET.	RETAINING
FF	FINISHED FLOOR
EOPP	EDGE OF POROUS PAVEMENT
EP	EDGE OF PAVEMENT
SWL	SINGLE WHITE LINE
DYL	DOUBLE YELLOW LINE
CONC.	CONCRETE
VGC	VERTICAL GRANITE CURB
SSC	SLOPED GRANITE CURB
VBB	VERTICAL BITUMINOUS BERM
COND.	CONDUIT
GREG	GAS REGULATOR
	PROPERTY LINE PER REF. PLAN
	GUARDRAIL
	STOCKADE FENCE
	CHAINLINK FENCE
	SEWER LINE
	DRAIN LINE
	GAS LINE (PER MARKINGS ON SITE)
	TREE LINE
	SEWER LINE PER REF. PLAN #1
	DRAIN LINE PER REF. PLAN #1
	GAS LINE PER REF. PLAN #1
	SEWER LINE PER REF. PLAN #1
	UNDERGROUND ELECTRIC LINE PER REF. PLAN #1

NOTES:

1. REFERENCE: TAX MAP 13, LOT 6-1 & 10-0
2. OWNER OF RECORD: BLUE ATLANTIC NEW HAMPSHIRE LLC
111 SOUTH WACKER DRIVE
SUITE 3300
CHICAGO, IL 60606
S.C.R.D. BOOK 4149, PAGE 537
3. FIELD SURVEY PERFORMED BY E.J.S. & N.J.M. DURING 10/14 & 11/14 USING A TRIMBLE S6 TOTAL STATION WITH A TRIMBLE TSC3 DATA COLLECTOR.
4. HORIZONTAL DATUM BASED ON NAD83(CORS96) NEW HAMPSHIRE STATE PLANE 2800 DERIVED FROM STATIC GPS OBSERVATIONS PROCESSED BY THE NATIONAL GEODETIC SURVEY ON-LINE POSITIONING USER SERVICE (OPUS).
5. VERTICAL DATUM IS BASED ON NGVD29 BASED ON PUBLISHED BENCHMARK DISKS UNH 17 AND DURHAM CBL 430.
6. BOUNDARY SHOWN HEREON IS BASED ON REFERENCE PLAN #2.
7. THE INTENT OF THIS PLAN IS TO SHOWN POST-CONSTRUCTION AS-BUILT CONDITIONS. IN AREAS WHERE NO AS-BUILT DATA FOR UNDERGROUND UTILITIES WAS AVAILABLE, INFORMATION IS SHOWN PER DESIGN PLAN. THIS PLAN IS NOT INTENDED FOR AID IN FUTURE DESIGN NOR IS IT A STATEMENT AS TO COMPLIANCE TO ZONING, BUILDING CODES OR APPROVED SITE PLAN.

REFERENCE PLANS:

1. "PEAK CAMPUS DEVELOPMENT, LLC MAST ROAD APARTMENTS DURHAM NH"
BY: TIGHE AND BOND CONSULTING ENGINEERS. DATED: NOVEMBER 11, 2012.
2. "ALTA/ACSM LAND TITLE SURVEY OF TAX MAP 13, LOTS 6-1 & 10-0 DURHAM NH"
BY: DOUCET SURVEY, INC. DATED: JUNE 25, 2013.

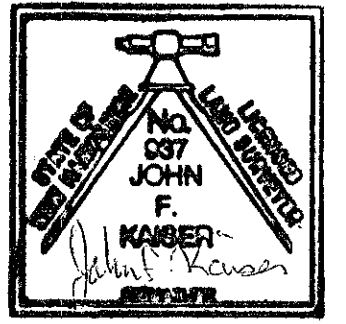



I certify that this survey and plan were prepared by me or by those under my direct supervision. I certify that this survey was made on the ground and is correct to the best of my knowledge and belief.

John F. Kensen L.I.S. #93
6/10/14 DATE

AS-BUILT SURVEY
OF
THE LODGES AT WEST EDGE
MAST ROAD
DURHAM, NEW HAMPSHIRE

DRAWN BY: E.J.S.	DATE: DEC. 12, 2014
CHECKED BY: J.F.K.	DRAWING NO.: 3567A
JOB NO.: 3567	SHEET 1 OF 5

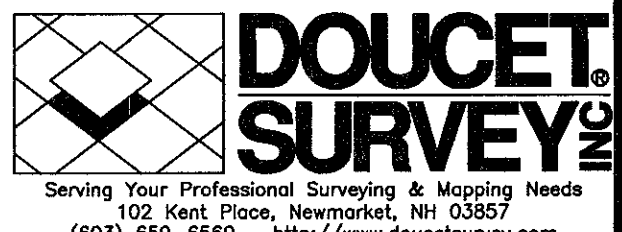
[illegible]

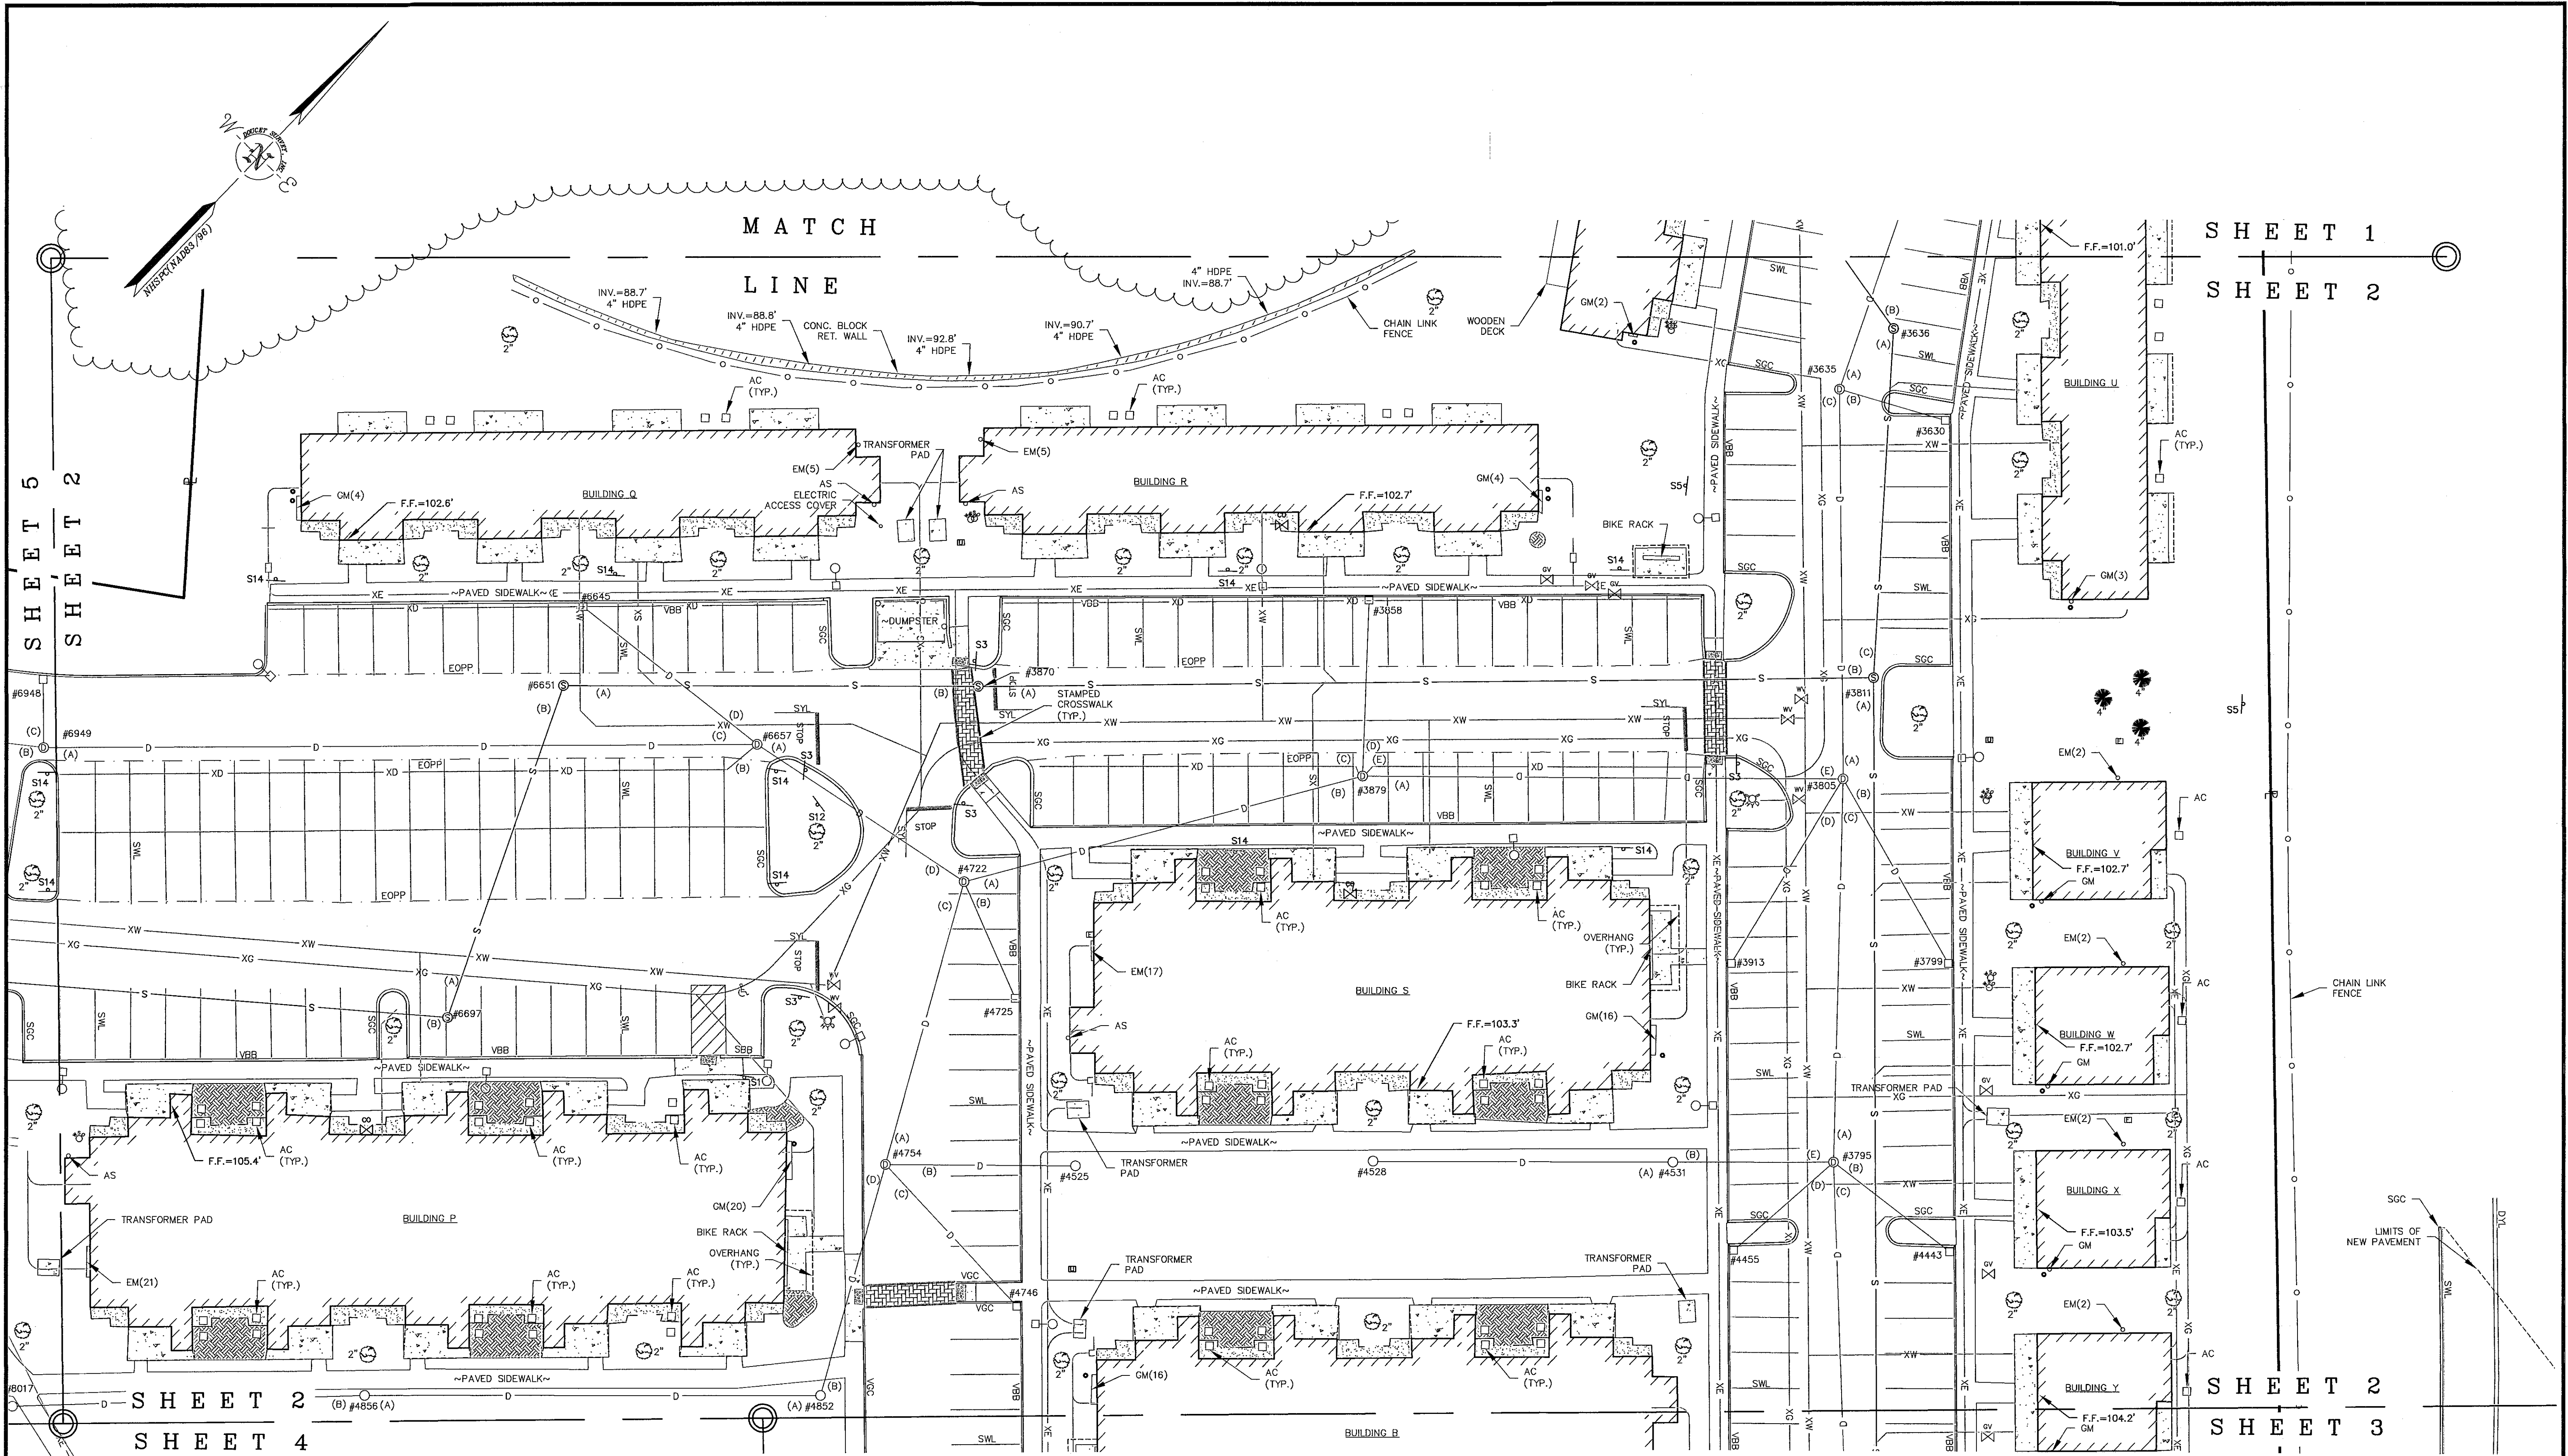

NOTE:
ALL ELECTRIC, GAS, TEL. WATER, SEWER AND DRAIN SERVICES ARE SHOWN IN SCHEMATIC
FASHION. THEIR LOCATIONS ARE NOT PRECISE OR NECESSARILY ACCURATE. NO WORK
WHATSOEVER SHALL BE UNDERTAKEN ON THIS SITE USING THIS PLAN TO LOCATE THE ABOVE
SERVICES. CONSULT WITH THE PROPER AUTHORITIES CONCERNED WITH THE SUBJECT SERVICE
LOCATIONS FOR INFORMATION REGARDING SUCH. CALL DIG-SAFE AT 1-888-DIG-SAFE.

I certify that this survey and plan were prepared by me
or by those under my direct supervision. I certify that this
survey was made on the ground and is correct to the best
of my knowledge and belief.


[Signature] L.L.S. #937
12/10/14 DATE

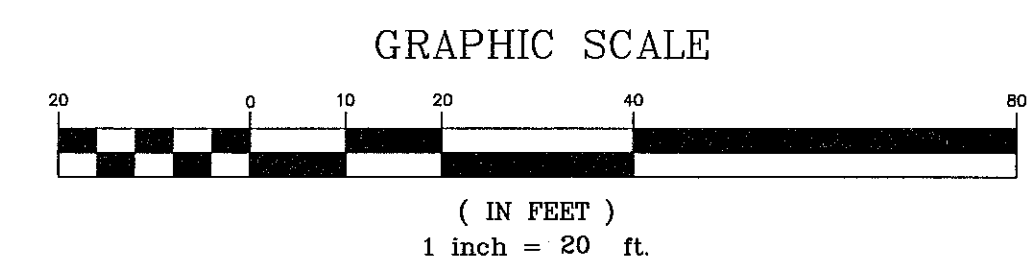

SIGN TABLE	
S1	"HANDICAPPED PARKING"
S2	"RESIDENTIAL PARKING"
S3	"STOP"
S4	"MOTORCYCLE PARKING"
S5	"PET WASTE"
S6	"THE LODGES"
S7	"YIELD CROSS WALK"
S8	"CAUTION TURN AHEAD"
S9	"25 MPH"
S10	"TRAILER PARKING ONLY"
S11	"LANE DIRECTION ARROW"
S12	"PERMIT PARKING ONLY"
S13	"NO PARKING"
S14	"POROUS PAVEMENT"
S15	"UNIT DIRECTORY"

DRAWN BY:	E.J.S.	DATE:	DEC. 12, 2014
CHECKED BY:	J.F.K.	DRAWING NO.:	3567A
JOB NO.:	3567	SHEET	2 OF 5

DOUCET SURVEYING
Serving Your Professional Surveying & Mapping Needs
102 Kent Place, Newmarket, NH 03857
(603) 659-6560 <http://www.doucetsurvey.com>

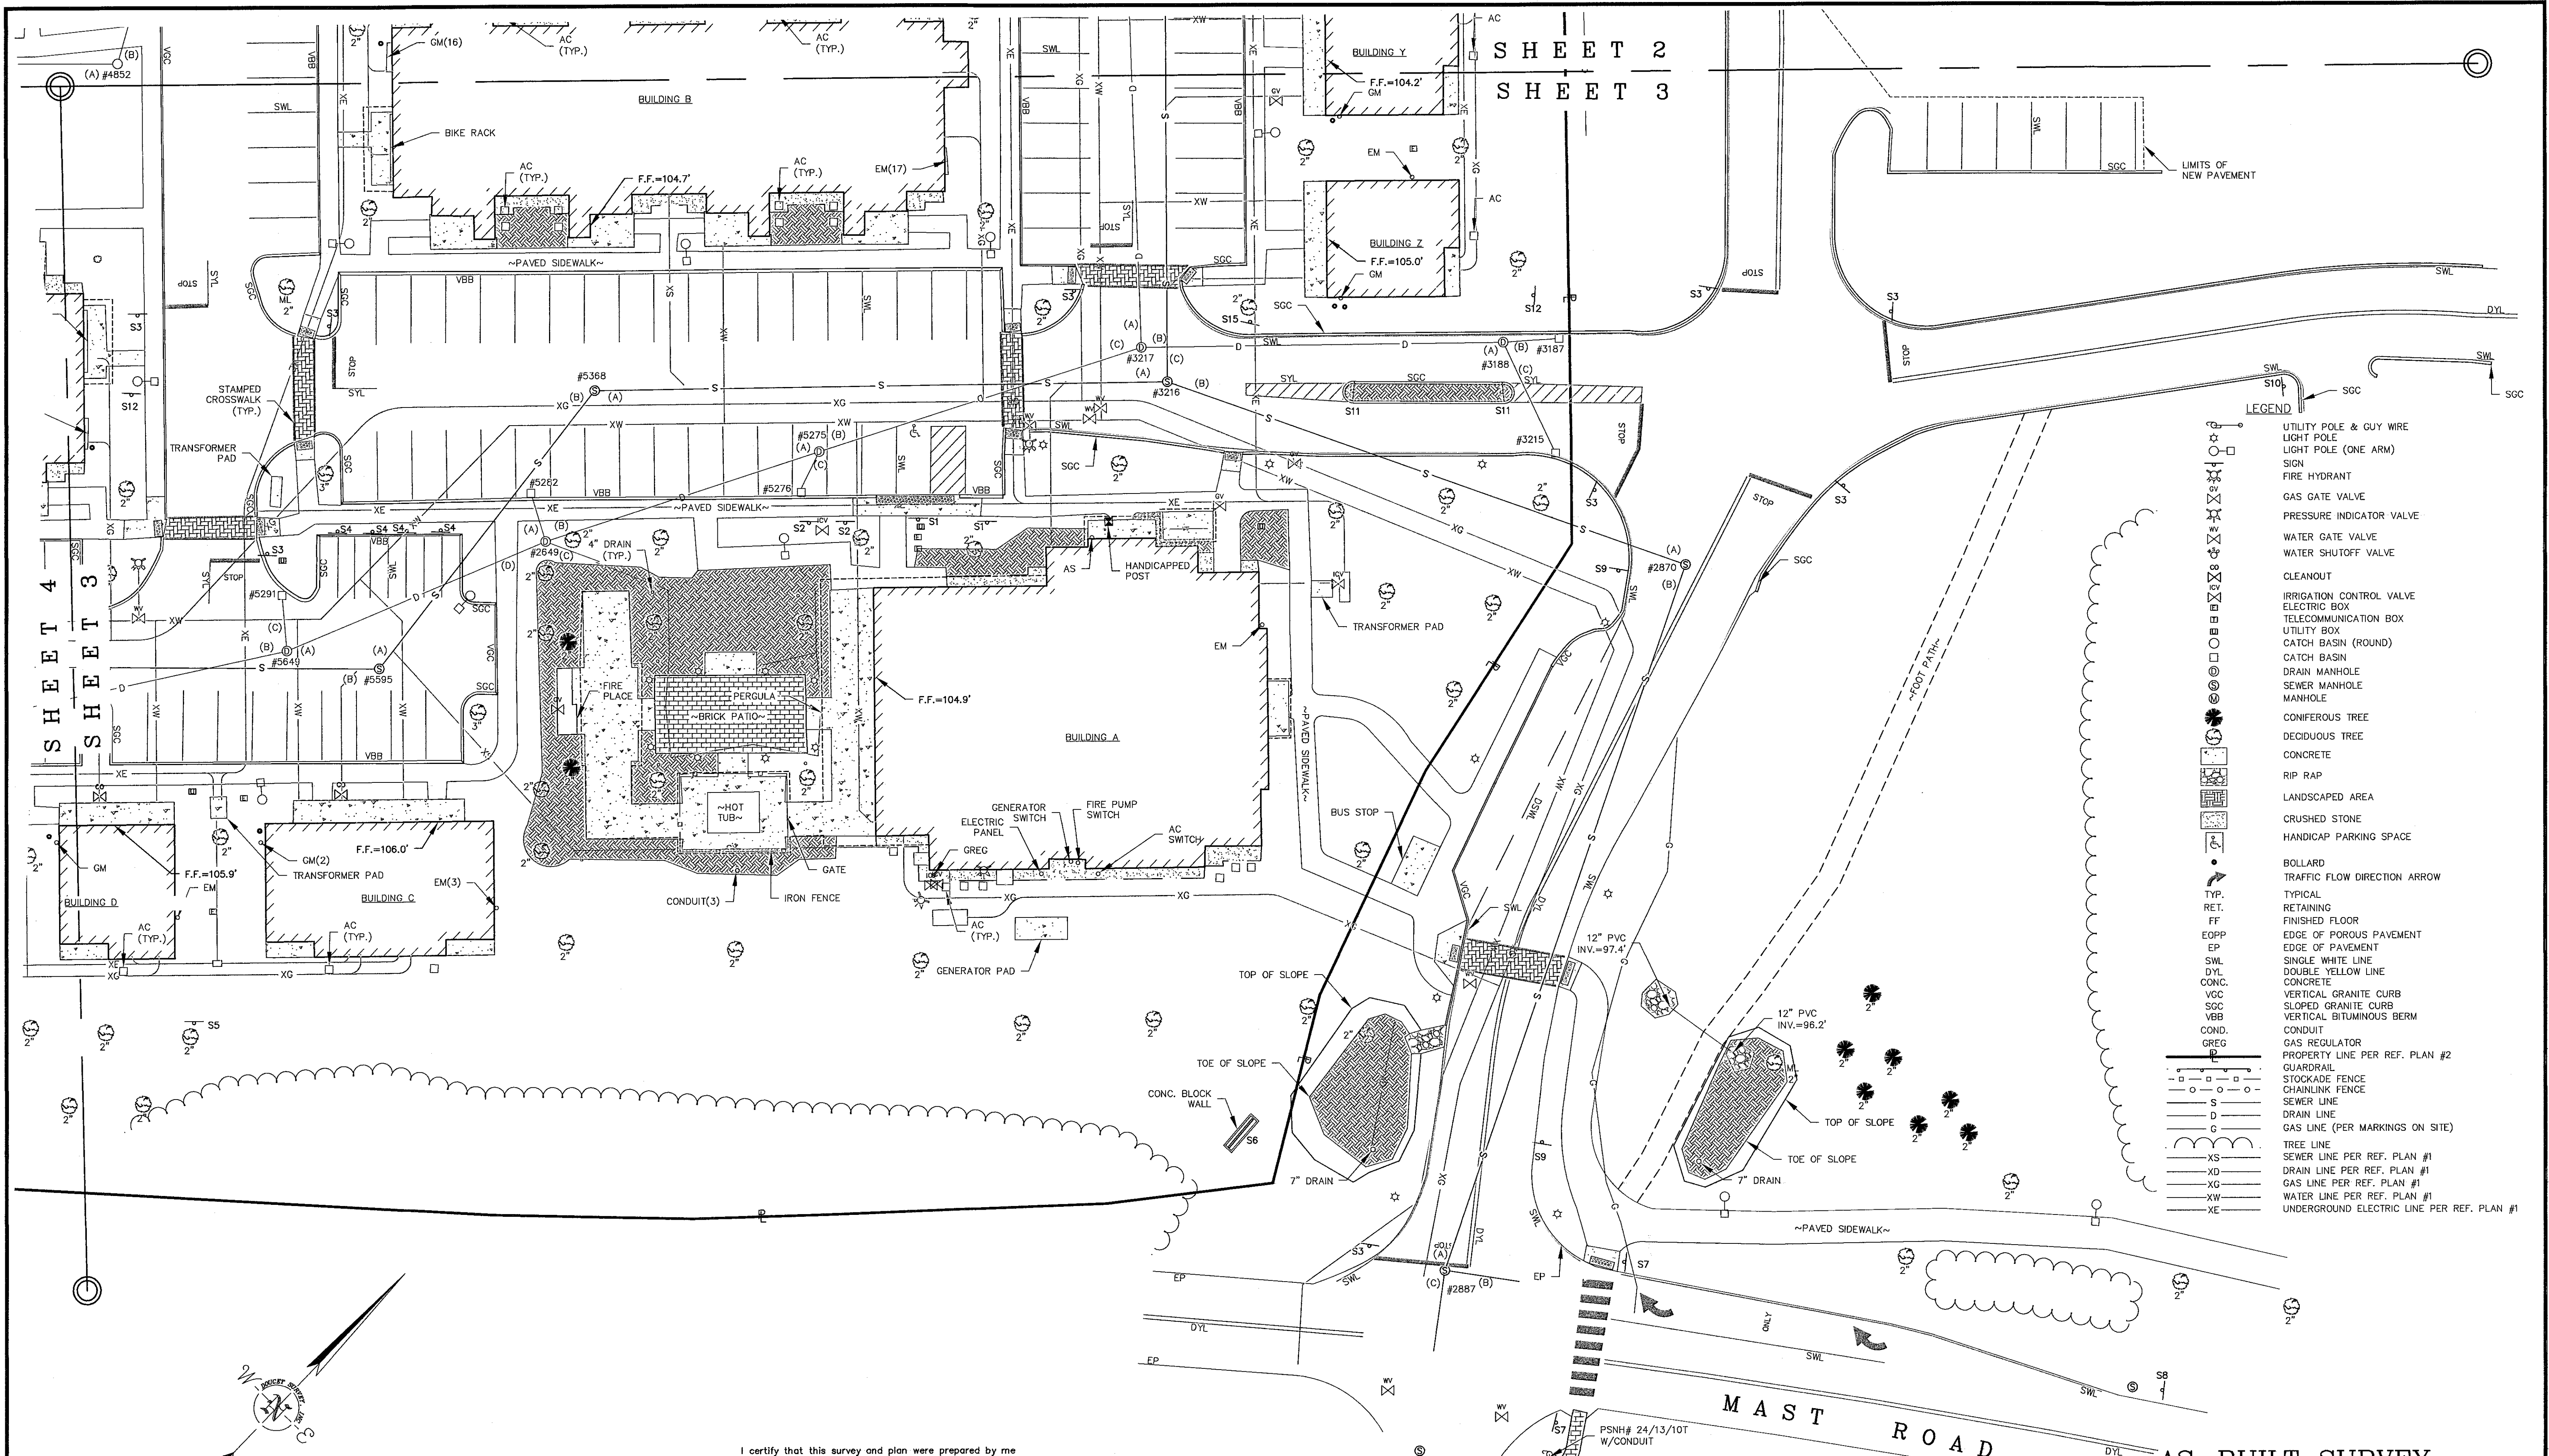


SHEET 2
SHEET 3

- LEGEND**
- UTILITY POLE & GUY WIRE
 - LIGHT POLE
 - LIGHT POLE (ONE ARM)
 - SIGN
 - FIRE HYDRANT
 - GAS GATE VALVE
 - PRESSURE INDICATOR VALVE
 - WATER GATE VALVE
 - WATER SHUTOFF VALVE
 - CLEANOUT
 - IRRIGATION CONTROL VALVE
 - ELECTRIC BOX
 - TELECOMMUNICATION BOX
 - UTILITY BOX
 - CATCH BASIN (ROUND)
 - CATCH BASIN
 - DRAIN MANHOLE
 - SEWER MANHOLE
 - MANHOLE
 - CONIFEROUS TREE
 - DECIDUOUS TREE
 - CONCRETE
 - RIP RAP
 - LANDSCAPED AREA
 - CRUSHED STONE
 - HANDICAP PARKING SPACE
 - BOLLARD
 - TRAFFIC FLOW DIRECTION ARROW
 - TYP.
 - RET.
 - FF
 - EOPP
 - EP
 - SWL
 - DYL
 - CONC.
 - VCC
 - SGC
 - VBB
 - COND.
 - GREG
 - PROPERTY LINE PER REF. PLAN #2
 - GUARDRAIL
 - STOCKADE FENCE
 - CHAINLINK FENCE
 - SEWER LINE
 - DRAIN LINE
 - GAS LINE (PER MARKINGS ON SITE)
 - TREE LINE
 - SEWER LINE PER REF. PLAN #1
 - DRAIN LINE PER REF. PLAN #1
 - GAS LINE PER REF. PLAN #1
 - WATER LINE PER REF. PLAN #1
 - UNDERGROUND ELECTRIC LINE PER REF. PLAN #1

I certify that this survey and plan were prepared by me or by those under my direct supervision. I certify that this survey was made on the ground and is correct to the best of my knowledge and belief.

John F. Kaiser L.L.S. #937
12/16/14 DATE

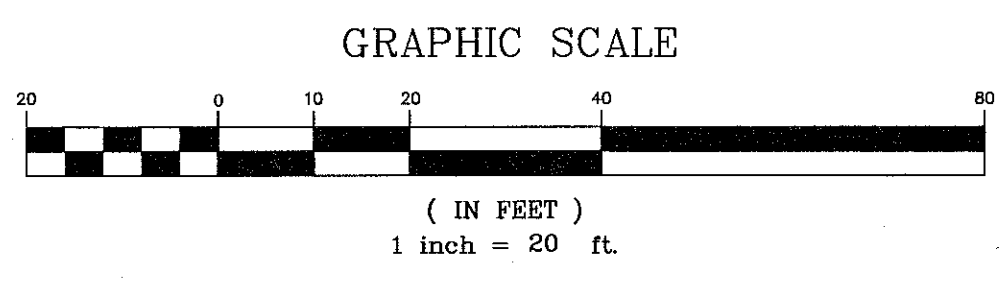

AS-BUILT SURVEY
OF
THE LODGES AT WEST EDGE
MAST ROAD
DURHAM, NEW HAMPSHIRE

SIGN TABLE


S1	"HANDICAPPED PARKING"
S2	"RESIDENTIAL PARKING"
S3	"STOP"
S4	"MOTORCYCLE PARKING"
S5	"PET WASTE"
S6	"THE LODGES"
S7	"YIELD CROSS WALK"
S8	"CAUTION, TURN AHEAD"
S9	"25 MPH"
S10	"TRAILER PARKING ONLY"
S11	"LANE DIRECTION ARROW"
S12	"PERMIT PARKING ONLY"
S13	"NO PARKING"
S14	"POROUS PAVEMENT"
S15	UNIT DIRECTORY

DRAWN BY:	E.J.S.	DATE:	DEC. 12, 2014
CHECKED BY:	J.F.K.	DRAWING NO.:	3567A
JOB NO.:	3567	SHEET	3 OF 5

DOUCET SURVEY
Serving Your Professional Surveying & Mapping Needs
102 Kent Place, Newmarket, NH 03857
(603) 535-6550 <http://www.doucetsurvey.com>

NO.	DATE	DESCRIPTION	BY

NOTE:
ALL ELECTRIC, GAS, TEL, WATER, SEWER AND DRAIN SERVICES ARE SHOWN IN SCHEMATIC FASHION. THEIR LOCATIONS ARE NOT PRECISE OR NECESSARILY ACCURATE. NO WORK WHATSOEVER SHALL BE UNDERTAKEN ON THIS SITE USING THIS PLAN TO LOCATE THE ABOVE SERVICES. CONSULT WITH THE PROPER AUTHORITIES CONCERNED WITH THE SUBJECT SERVICE LOCATIONS FOR INFORMATION REGARDING SUCH. CALL DIG-SAFE AT 1-888-DIG-SAFE.

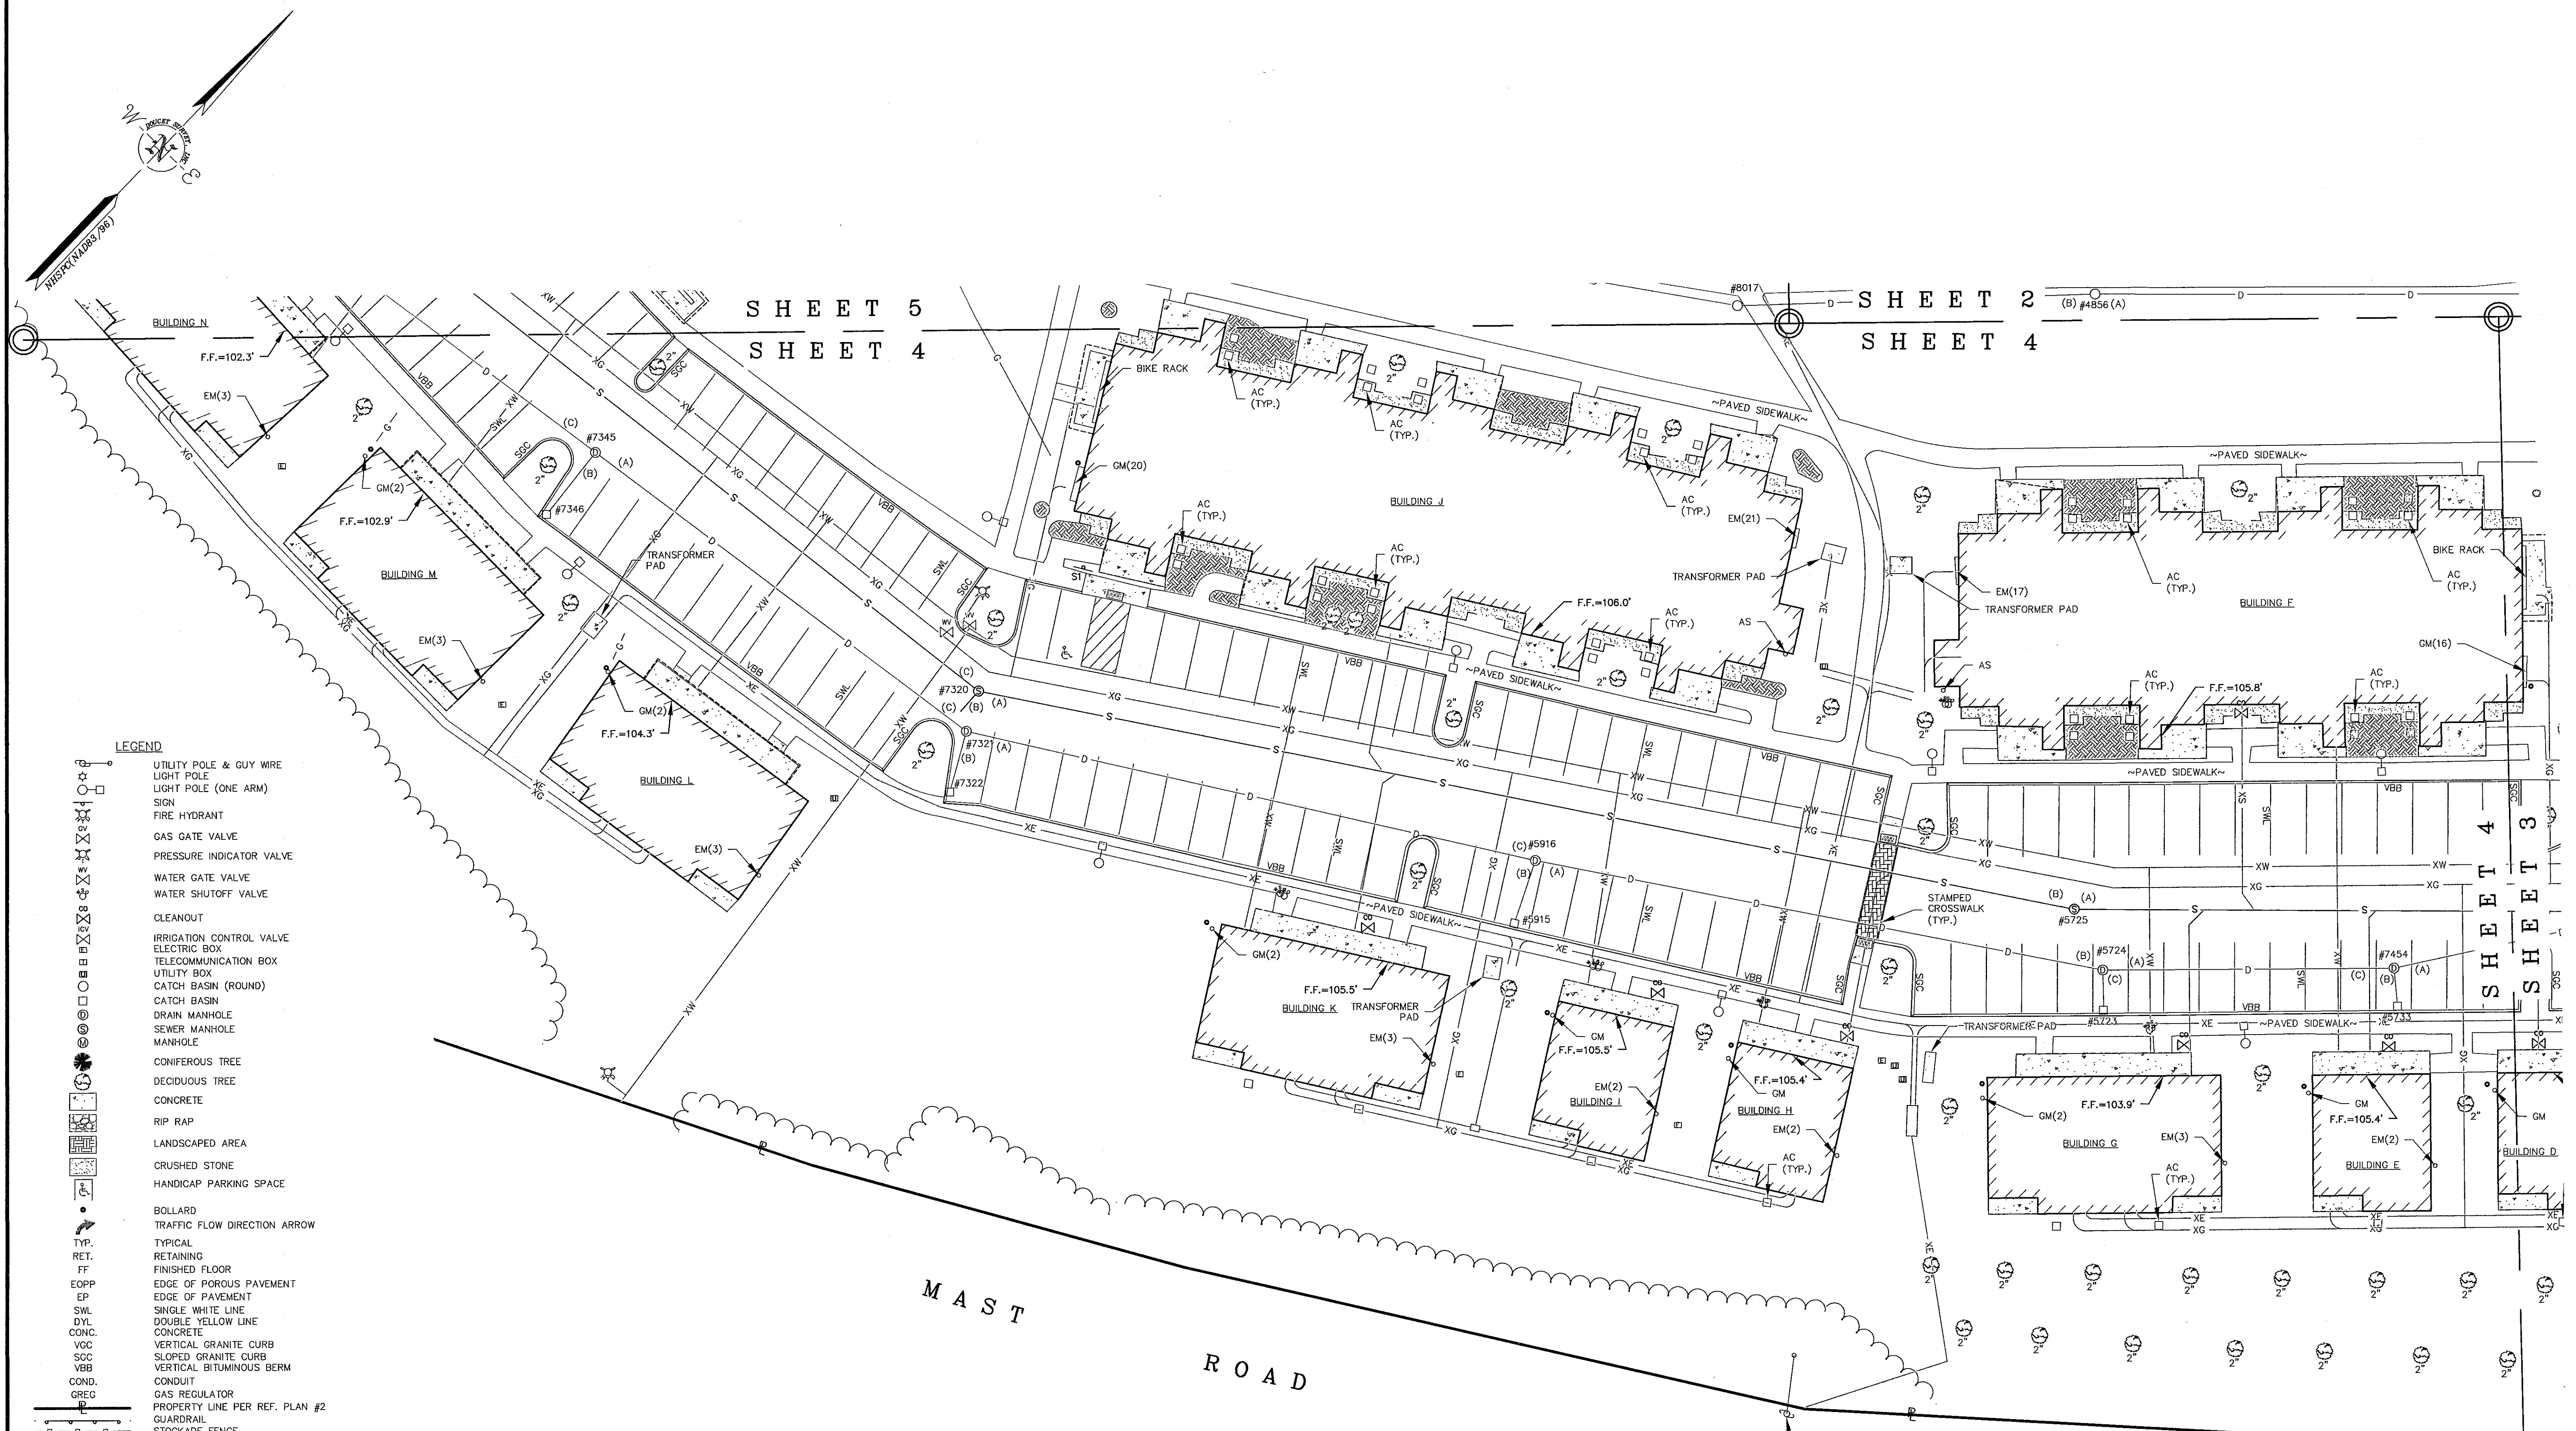


LEGEND

- UTILITY POLE & GUY WIRE
- LIGHT POLE
- LIGHT POLE (ONE ARM)
- SIGN
- FIRE HYDRANT
- GAS GATE VALVE
- PRESSURE INDICATOR VALVE
- WATER GATE VALVE
- WATER SHUTOFF VALVE
- CLEANOUT
- IRRIGATION CONTROL VALVE
- ELECTRIC BOX
- TELECOMMUNICATION BOX
- UTILITY BOX
- CATCH BASIN (ROUND)
- CATCH BASIN
- DRAIN MANHOLE
- SEWER MANHOLE
- MANHOLE
- CONIFEROUS TREE
- DECIDUOUS TREE
- CONCRETE
- RIP RAP
- LANDSCAPED AREA
- CRUSHED STONE
- HANDICAP PARKING SPACE
- BOLLARD
- TRAFFIC FLOW DIRECTION ARROW
- TYP.
- RET.
- FF
- EQPP
- EP
- SWL
- DYL
- CONC.
- VGC
- SGC
- VBB
- COND.
- GREO
- PROPERTY LINE PER REF. PLAN #2
- GUARDRAIL
- STOCKADE FENCE
- CHAINLINK FENCE
- SEWER LINE
- DRAIN LINE
- GAS LINE (PER MARKINGS ON SITE)
- TREE LINE
- SEWER LINE PER REF. PLAN #1
- DRAIN LINE PER REF. PLAN #1
- GAS LINE PER REF. PLAN #1
- WATER LINE PER REF. PLAN #1
- UNDERGROUND ELECTRIC LINE PER REF. PLAN #1


NOTE:
ALL ELECTRIC, GAS, TEL, WATER, SEWER AND DRAIN SERVICES ARE SHOWN IN SCHEMATIC FASHION, THEIR LOCATIONS ARE NOT PRECISE OR NECESSARILY ACCURATE. NO WORK WHATSOEVER SHALL BE UNDERTAKEN ON THIS SITE USING THIS PLAN TO LOCATE THE ABOVE SERVICES. CONSULT WITH THE PROPER AUTHORITIES CONCERNED WITH THE SUBJECT SERVICE LOCATIONS FOR INFORMATION REGARDING SUCH. CALL DIG-SAFE AT 1-888-DIG-SAFE.

I certify that this survey and plan were prepared by me or by those under my direct supervision. I certify that this survey was made on the ground and is correct to the best of my knowledge and belief.

John P. Kaiser L.L.S. #937
12/10/14 DATE

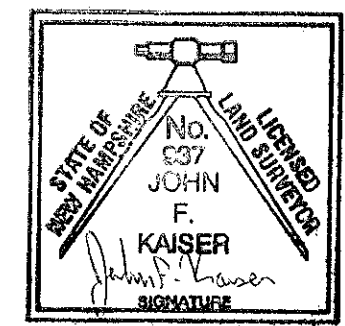

GRAPHIC SCALE

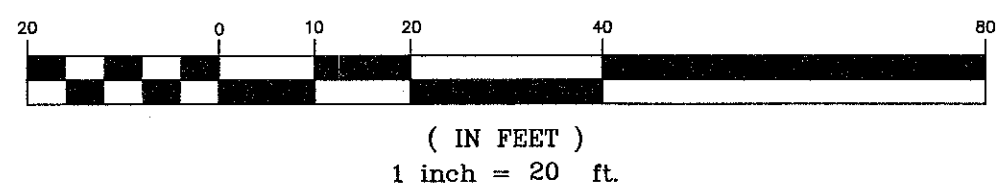


SIGN TABLE

- S1 "HANDICAPPED PARKING"
- S2 "RESIDENTIAL PARKING"
- S3 "STOP"
- S4 "MOTORCYCLE PARKING"
- S5 "PET WASTE"
- S6 "THE LODGES"
- S7 "YIELD CROSS WALK"
- S8 "CAUTION TURN AHEAD"
- S9 "25 MPH"
- S10 "TRAILER PARKING ONLY"
- S11 LANE DIRECTION ARROW
- S12 "PERMIT PARKING ONLY"
- S13 "NO PARKING"
- S14 "POROUS PAVEMENT"
- S15 UNIT DIRECTORY

DRAWN BY: E.J.S. DATE: DEC. 12, 2014
CHECKED BY: J.F.K. DRAWING NO.: 3567A
JOB NO.: 3567 SHEET 4 OF 5

AS-BUILT SURVEY
OF
THE LODGES AT WEST EDGE
MAST ROAD
DURHAM, NEW HAMPSHIRE



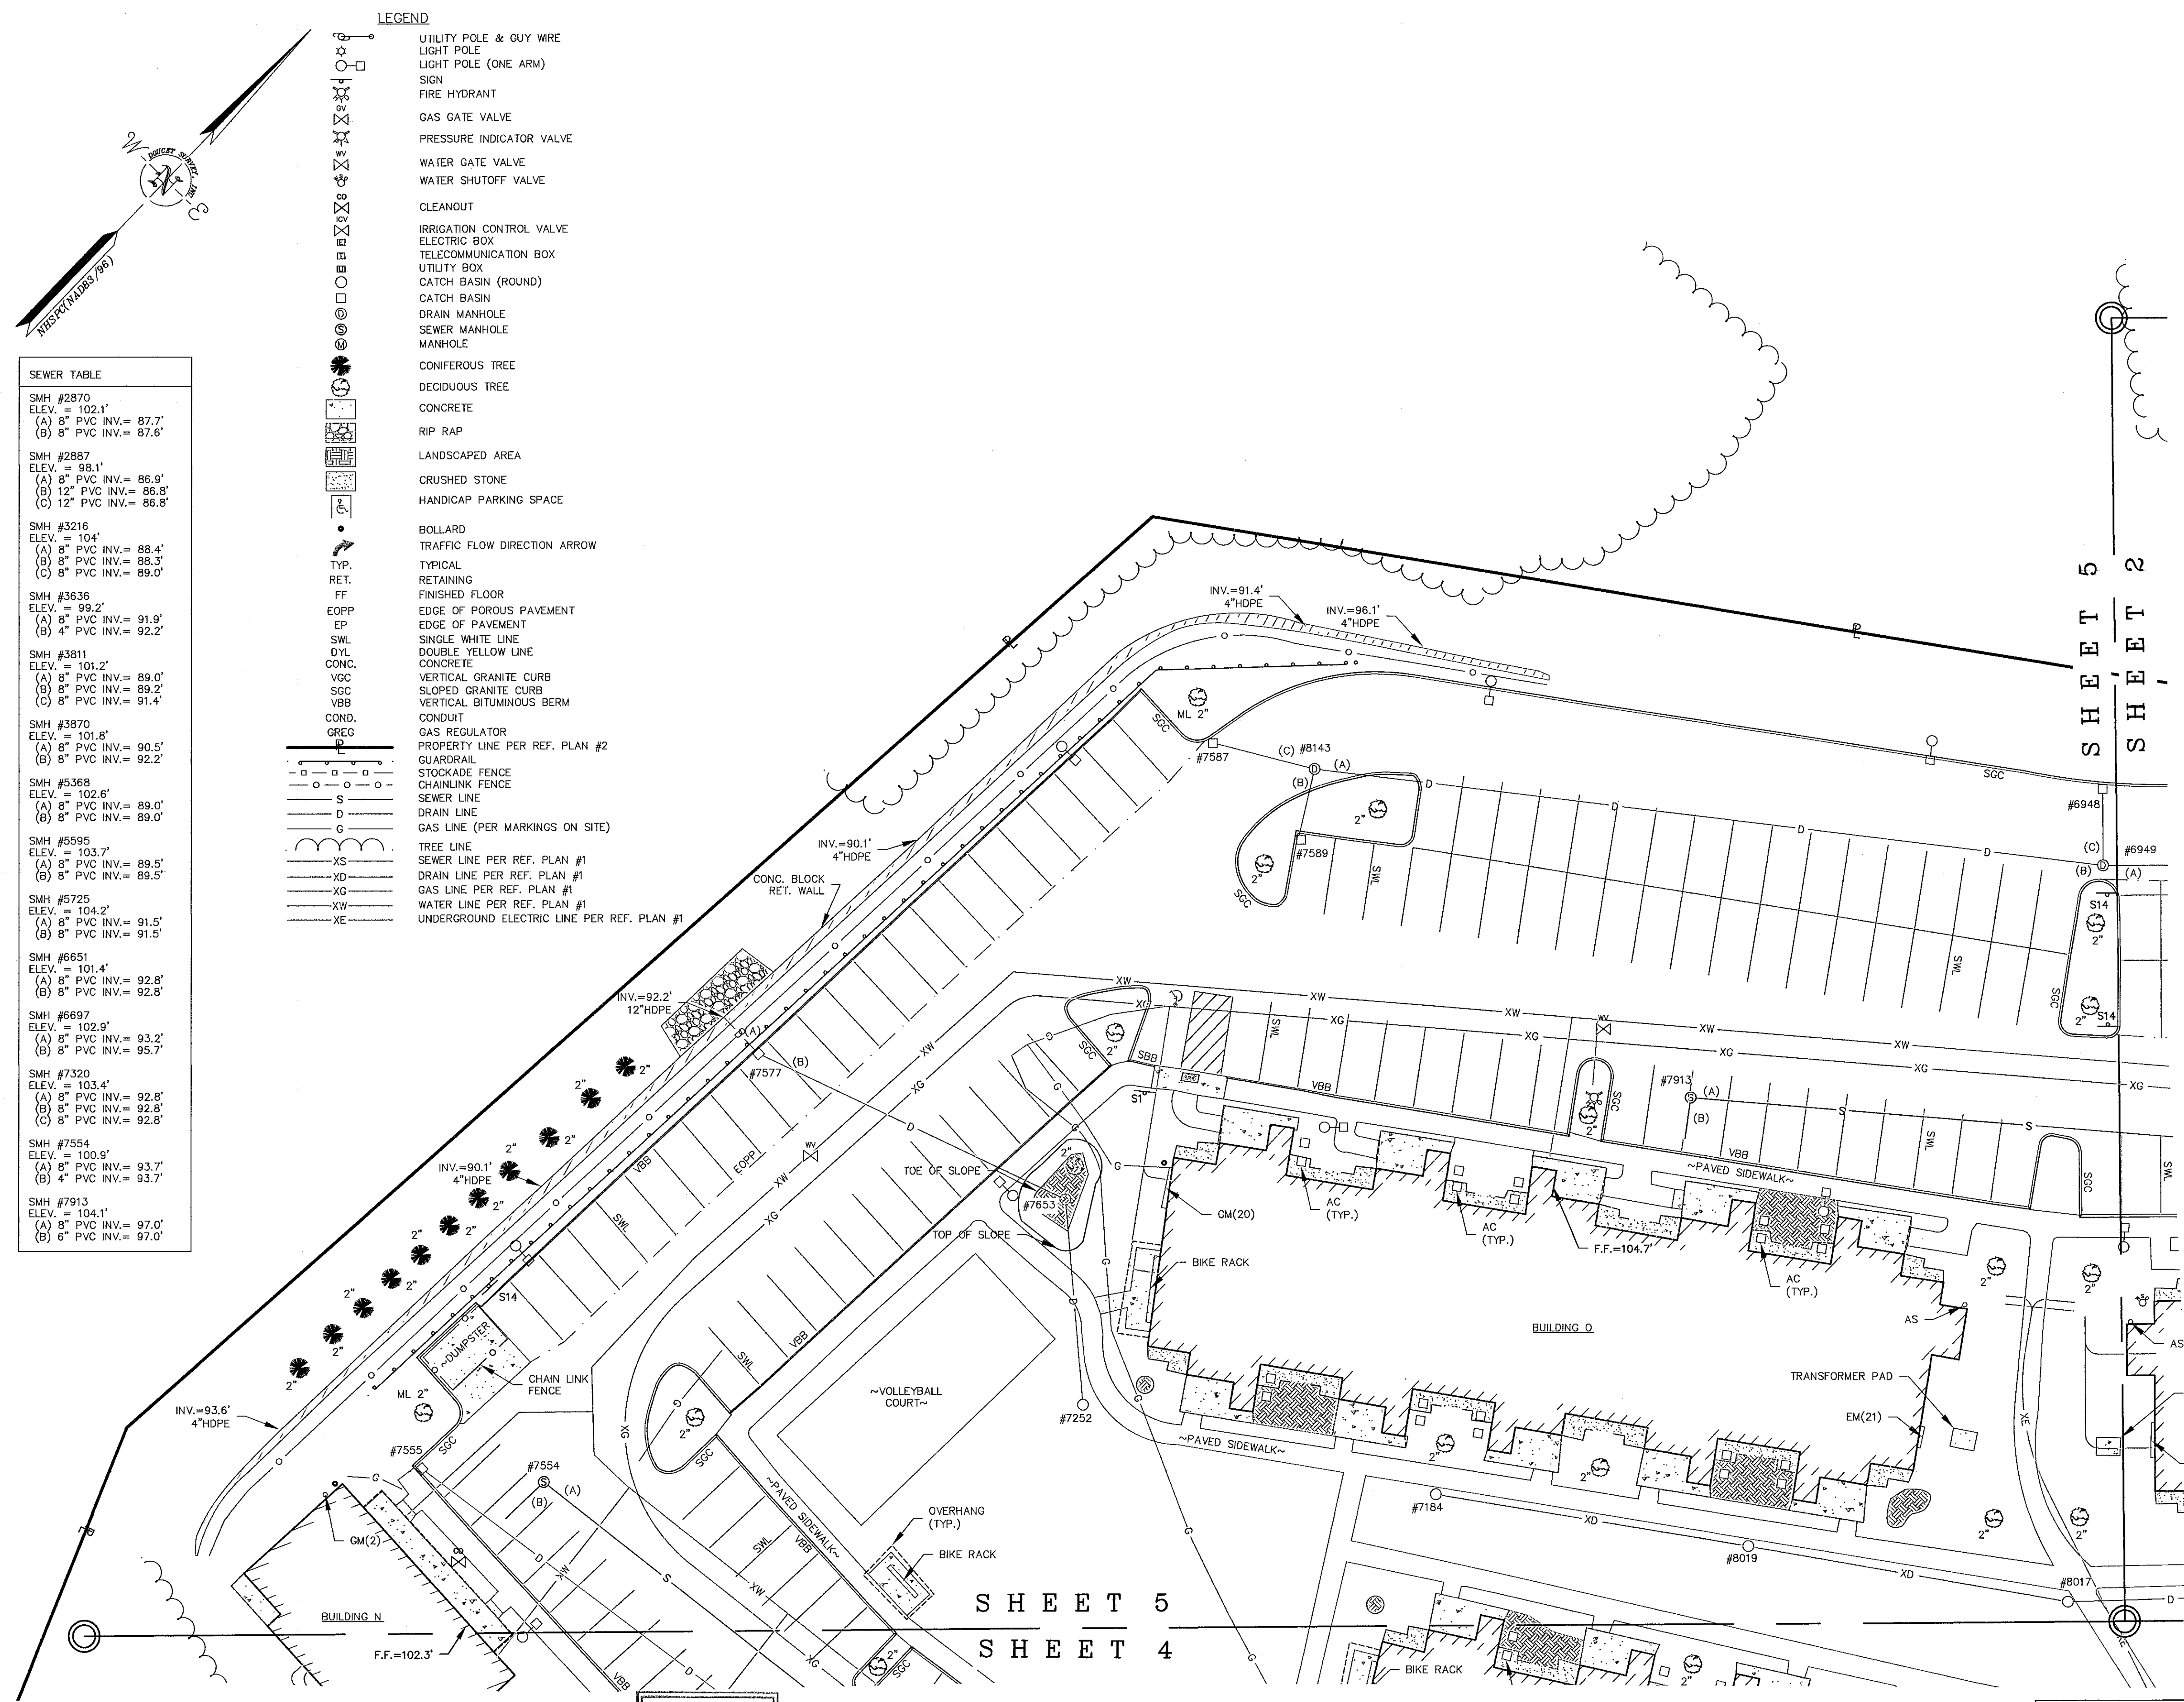

SEWER TABLE			
SMH #2870	ELEV. = 102.1'		
(A) 8" PVC INV. = 87.7'			
(B) 8" PVC INV. = 87.6'			
SMH #2887	ELEV. = 98.1'		
(A) 8" PVC INV. = 86.9'			
(B) 12" PVC INV. = 86.8'			
(C) 12" PVC INV. = 86.8'			
SMH #3216	ELEV. = 104'		
(A) 8" PVC INV. = 88.4'			
(B) 8" PVC INV. = 88.3'			
(C) 8" PVC INV. = 89.0'			
SMH #3636	ELEV. = 99.2'		
(A) 8" PVC INV. = 91.9'			
(B) 4" PVC INV. = 92.2'			
SMH #3811	ELEV. = 101.2'		
(A) 8" PVC INV. = 89.0'			
(B) 8" PVC INV. = 89.2'			
(C) 8" PVC INV. = 91.4'			
SMH #3870	ELEV. = 101.8'		
(A) 8" PVC INV. = 90.5'			
(B) 8" PVC INV. = 92.2'			
SMH #5368	ELEV. = 102.6'		
(A) 8" PVC INV. = 89.0'			
(B) 8" PVC INV. = 89.0'			
SMH #5595	ELEV. = 103.7'		
(A) 8" PVC INV. = 89.5'			
(B) 8" PVC INV. = 89.5'			
SMH #5725	ELEV. = 104.2'		
(A) 8" PVC INV. = 91.5'			
(B) 8" PVC INV. = 91.5'			
SMH #6651	ELEV. = 101.4'		
(A) 8" PVC INV. = 92.8'			
(B) 8" PVC INV. = 92.8'			
SMH #6697	ELEV. = 102.9'		
(A) 8" PVC INV. = 93.2'			
(B) 8" PVC INV. = 95.7'			
SMH #7320	ELEV. = 103.4'		
(A) 8" PVC INV. = 92.8'			
(B) 8" PVC INV. = 92.8'			
(C) 8" PVC INV. = 92.8'			
SMH #7554	ELEV. = 100.9'		
(A) 8" PVC INV. = 93.7'			
(B) 4" PVC INV. = 93.7'			
SMH #7913	ELEV. = 104.1'		
(A) 8" PVC INV. = 97.0'			
(B) 6" PVC INV. = 97.0'			

LEGEND	
	UTILITY POLE & GUY WIRE
	LIGHT POLE
	LIGHT POLE (ONE ARM)
	SIGN
	FIRE HYDRANT
	GAS GATE VALVE
	PRESSURE INDICATOR VALVE
	WATER GATE VALVE
	WATER SHUTOFF VALVE
	CLEANOUT
	IRRIGATION CONTROL VALVE
	ELECTRIC BOX
	TELECOMMUNICATION BOX
	UTILITY BOX
	CATCH BASIN (ROUND)
	CATCH BASIN
	DRAIN MANHOLE
	SEWER MANHOLE
	MANHOLE
	CONIFEROUS TREE
	DECIDUOUS TREE
	CONCRETE
	RIP RAP
	LANDSCAPED AREA
	CRUSHED STONE
	HANDICAP PARKING SPACE
	BOLLARD
	TRAFFIC FLOW DIRECTION ARROW
	TYPICAL RETAINING WALL
	FINISHED FLOOR
	EDGE OF POROUS PAVEMENT
	EDGE OF PAVEMENT
	SINGLE WHITE LINE
	DOUBLE YELLOW LINE
	CONCRETE
	VERTICAL GRANITE CURB
	SLOPED GRANITE CURB
	VERTICAL BITUMINOUS BERM
	VBB
	CONDUIT
	GAS REGULATOR
	PROPERTY LINE PER REF. PLAN #2
	GUARDRAIL
	STOCKADE FENCE
	CHAIN LINK FENCE
	SEWER LINE
	DRAIN LINE
	GAS LINE (PER MARKINGS ON SITE)
	TREE LINE
	SEWER LINE PER REF. PLAN #1
	DRAIN LINE PER REF. PLAN #1
	GAS LINE PER REF. PLAN #1
	WATER LINE PER REF. PLAN #1
	UNDERGROUND ELECTRIC LINE PER REF. PLAN #1


DRAINAGE TABLE		
DMH #2649	ELEV. = 103.2'	CB #4455
RIM ELEV. = 103.2'		ELEV. = 102.5'
(A) 12" HDPE INV. = 96.9'		HOODED OUTLET
(B) 18" HDPE INV. = 93.4'		WATER ELEV. = 97.9'
(C) 6" HDPE INV. = 98.2'		
(D) 18" HDPE INV. = 93.5'		CB #4525
		ELEV. = 102.1'
CB #3187	ELEV. = 102.8'	12" PVC INV. = 97.8'
HOODED OUTLET		
WATER ELEV. = 97.5'		CB #4528
		ELEV. = 102.5'
		12" PVC INV. = 97.7'
DMH #3188	ELEV. = 103.1'	CB #4531
ELEV. = 103.1'		ELEV. = 102.1'
(A) 12" HDPE INV. = 97.1'		(A) 12" PVC INV. = 97.3'
(B) 12" HDPE INV. = 97.4'		(B) 12" PVC INV. = 97.1'
(C) 12" HDPE INV. = 97.4'		
CB #3215	ELEV. = 102.7'	DMH #4722
HOODED OUTLET		ELEV. = 102'
WATER ELEV. = 97.6'		(A) 18" HDPE INV. = 93.9'
		(B) 12" HDPE INV. = 96.3'
		(C) 12" HDPE INV. = 96.7'
		(D) 12" HDPE INV. = 94.1'
DMH #3217	ELEV. = 104'	CB #4725
ELEV. = 104'		ELEV. = 101.5'
(A) 24" HDPE INV. = 92.5'		HOODED OUTLET
(B) 12" HDPE INV. = 96.6'		WATER ELEV. = 96.6'
(C) 18" HDPE INV. = 92.3'		
DMH #3447	ELEV. = 92.6'	CB #4746
ELEV. = 92.6'		ELEV. = 102.7'
(A) 24" HDPE INV. = 89.1'		HOODED OUTLET
(B) 24" HDPE INV. = 88.9'		WATER ELEV. = 97.7'
DMH #3553	ELEV. = 98.1'	DMH #4754
ELEV. = 98.1'		ELEV. = 102.6'
(A) 24" HDPE INV. = 89.6'		(A) 12" HDPE INV. = 97.1'
(B) 12" HDPE INV. = 90.5'		(B) 12" HDPE INV. = 97.4'
(C) 24" HDPE INV. = 90.2'		(C) 12" HDPE INV. = 97.4'
		(D) 12" HDPE INV. = 97.4'
CB #3630	ELEV. = 99.4'	CB #4852
HOODED OUTLET		ELEV. = 102.7'
WATER ELEV. = 94.4'		(A) 12" HDPE INV. = 97.8'
		(B) 12" HDPE INV. = 97.7'
DMH #3635	ELEV. = 99.8'	CB #4856
ELEV. = 99.8'		ELEV. = 103.5'
(A) 24" HDPE INV. = 90.6'		(A) 12" PVC INV. = 98.5'
(B) 12" HDPE INV. = 94.1'		(B) 12" PVC INV. = 98.5'
(C) 24" HDPE INV. = 90.5'		
CB #3645	ELEV. = 97.8'	DMH #5275
HOODED OUTLET		ELEV. = 102.4'
WATER ELEV. = 91.3'		(A) 18" HDPE INV. = 93.1'
		(B) 18" HDPE INV. = 93.2'
DMH #3795	ELEV. = 102.5'	(C) 12" HDPE INV. = 97.0'
ELEV. = 102.5'		CB #5276
(A) 24" HDPE INV. = 91.8'		ELEV. = 102'
(B) 12" HDPE INV. = 97.4'		HOODED OUTLET
(C) 24" HDPE INV. = 91.7'		WATER ELEV. = 97.2'
(D) 12" HDPE INV. = 97.7'		
(E) 12" HDPE INV. = 96.8'		CB #5282
		ELEV. = 102.1'
CB #3799	ELEV. = 100.9'	HOODED OUTLET
HOODED OUTLET		WATER ELEV. = 97.1'
WATER ELEV. = 96.1'		
DMH #3805	ELEV. = 101.7'	CB #5291
ELEV. = 101.7'		ELEV. = 103.1'
(A) 24" HDPE INV. = 91.1'		HOODED OUTLET
(B) 12" HDPE INV. = 96.1'		WATER ELEV. = 98.0'
(C) 24" HDPE INV. = 91.8'		
(D) 12" HDPE INV. = 96.1'		DMH #5649
(E) 15" HDPE INV. = 92.3'		ELEV. = 103.5'
		(A) 18" HDPE INV. = 93.9'
CB #3858	ELEV. = 100.3'	(B) 18" HDPE INV. = 93.9'
ELEV. = 100.3'		(C) 12" HDPE INV. = 98.0'
(PARKED OVER)		CB #5723
		ELEV. = 103.3'
DMH #3879	ELEV. = 101.4'	HOODED OUTLET
ELEV. = 101.4'		WATER ELEV. = 98.7'
(A) 18" HDPE INV. = 93.5'		
(B) 18" HDPE INV. = 93.5'		DMH #5724
(C) 6" HDPE INV. = 98.6'		ELEV. = 103.7'
(D) 12" HDPE INV. = 94.7'		(A) 18" HDPE INV. = 94.7'
(E) 6" HDPE INV. = 98.6'		(B) 18" HDPE INV. = 94.6'
		(C) 12" HDPE INV. = 98.5'
CB #3913	ELEV. = 101'	CB #5733
HOODED OUTLET		ELEV. = 103.6'
WATER ELEV. = 95.9'		HOODED OUTLET
		WATER ELEV. = 98.8'
CB #4443	ELEV. = 102.4'	CB #5915
HOODED OUTLET		ELEV. = 103.4'
WATER ELEV. = 96.0'		HOODED OUTLET
		WATER ELEV. = 98.7'
		DMH #5916
		ELEV. = 103.9'
		(A) 18" HDPE INV. = 95.4'
		(B) 12" HDPE INV. = 98.2'
		(C) 12" HDPE INV. = 95.5'

NO.	DATE	DESCRIPTION	BY

NOTE:
ALL ELECTRIC, GAS, TEL. WATER, SEWER AND DRAIN SERVICES ARE SHOWN IN SCHEMATIC
FASHION. THEIR LOCATIONS ARE NOT PRECISE OR NECESSARILY ACCURATE. NO WORK
WHATSOEVER SHALL BE UNDERTAKEN ON THIS SITE USING THIS PLAN TO LOCATE THE ABOVE
SERVICES. CONSULT WITH THE PROPER AUTHORITIES CONCERNED WITH THE SUBJECT SERVICE
LOCATIONS FOR INFORMATION REGARDING SUCH. CALL DIG-SAFE AT 1-888-DIG-SAFE.

I certify that this survey and plan were prepared by me
or by those under my direct supervision. I certify that this
survey was made on the ground and is correct to the best
of my knowledge and belief.

John F. Kaiser L.L.S. #937
12/10/14 DATE

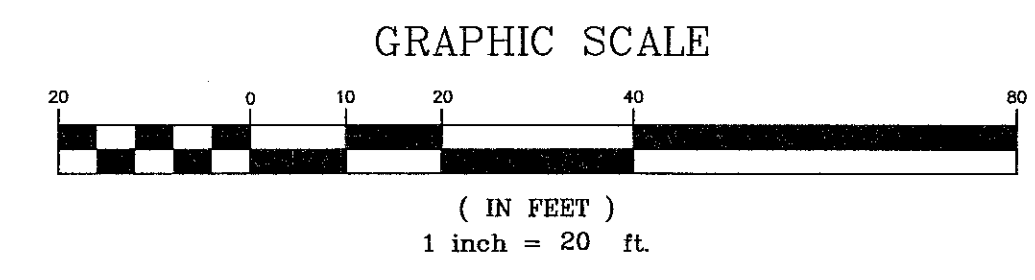

SIGN TABLE	
S1	"HANDICAPPED PARKING"
S2	"RESIDENTIAL PARKING"
S3	"STOP"
S4	"MOTORCYCLE PARKING"
S5	"PET WASTE"
S6	"THE LODGES"
S7	"YIELD CROSS WALK"
S8	"CAUTION TURN AHEAD"
S9	"25 MPH"
S10	"TRAILER PARKING ONLY"
S11	"LANE DIRECTION ARROW"
S12	"PERMIT PARKING ONLY"
S13	"NO PARKING"
S14	"POROUS PAVEMENT"
S15	UNIT DIRECTORY

DRAWN BY:	E.J.S.	DATE:	DEC. 12, 2014
CHECKED BY:	J.F.K.	DRAWING NO.:	3567A
JOB NO.:	3567	SHEET	5 OF 5

AS-BUILT SURVEY
OF
THE LODGES AT WEST EDGE
MAST ROAD
DURHAM, NEW HAMPSHIRE

DOUCET SURVEY
Serving Your Professional Surveying & Mapping Needs
102 Kent Place, Newmarket, NH 03857
(603) 859-6500 <http://www.doucetsurvey.com>