


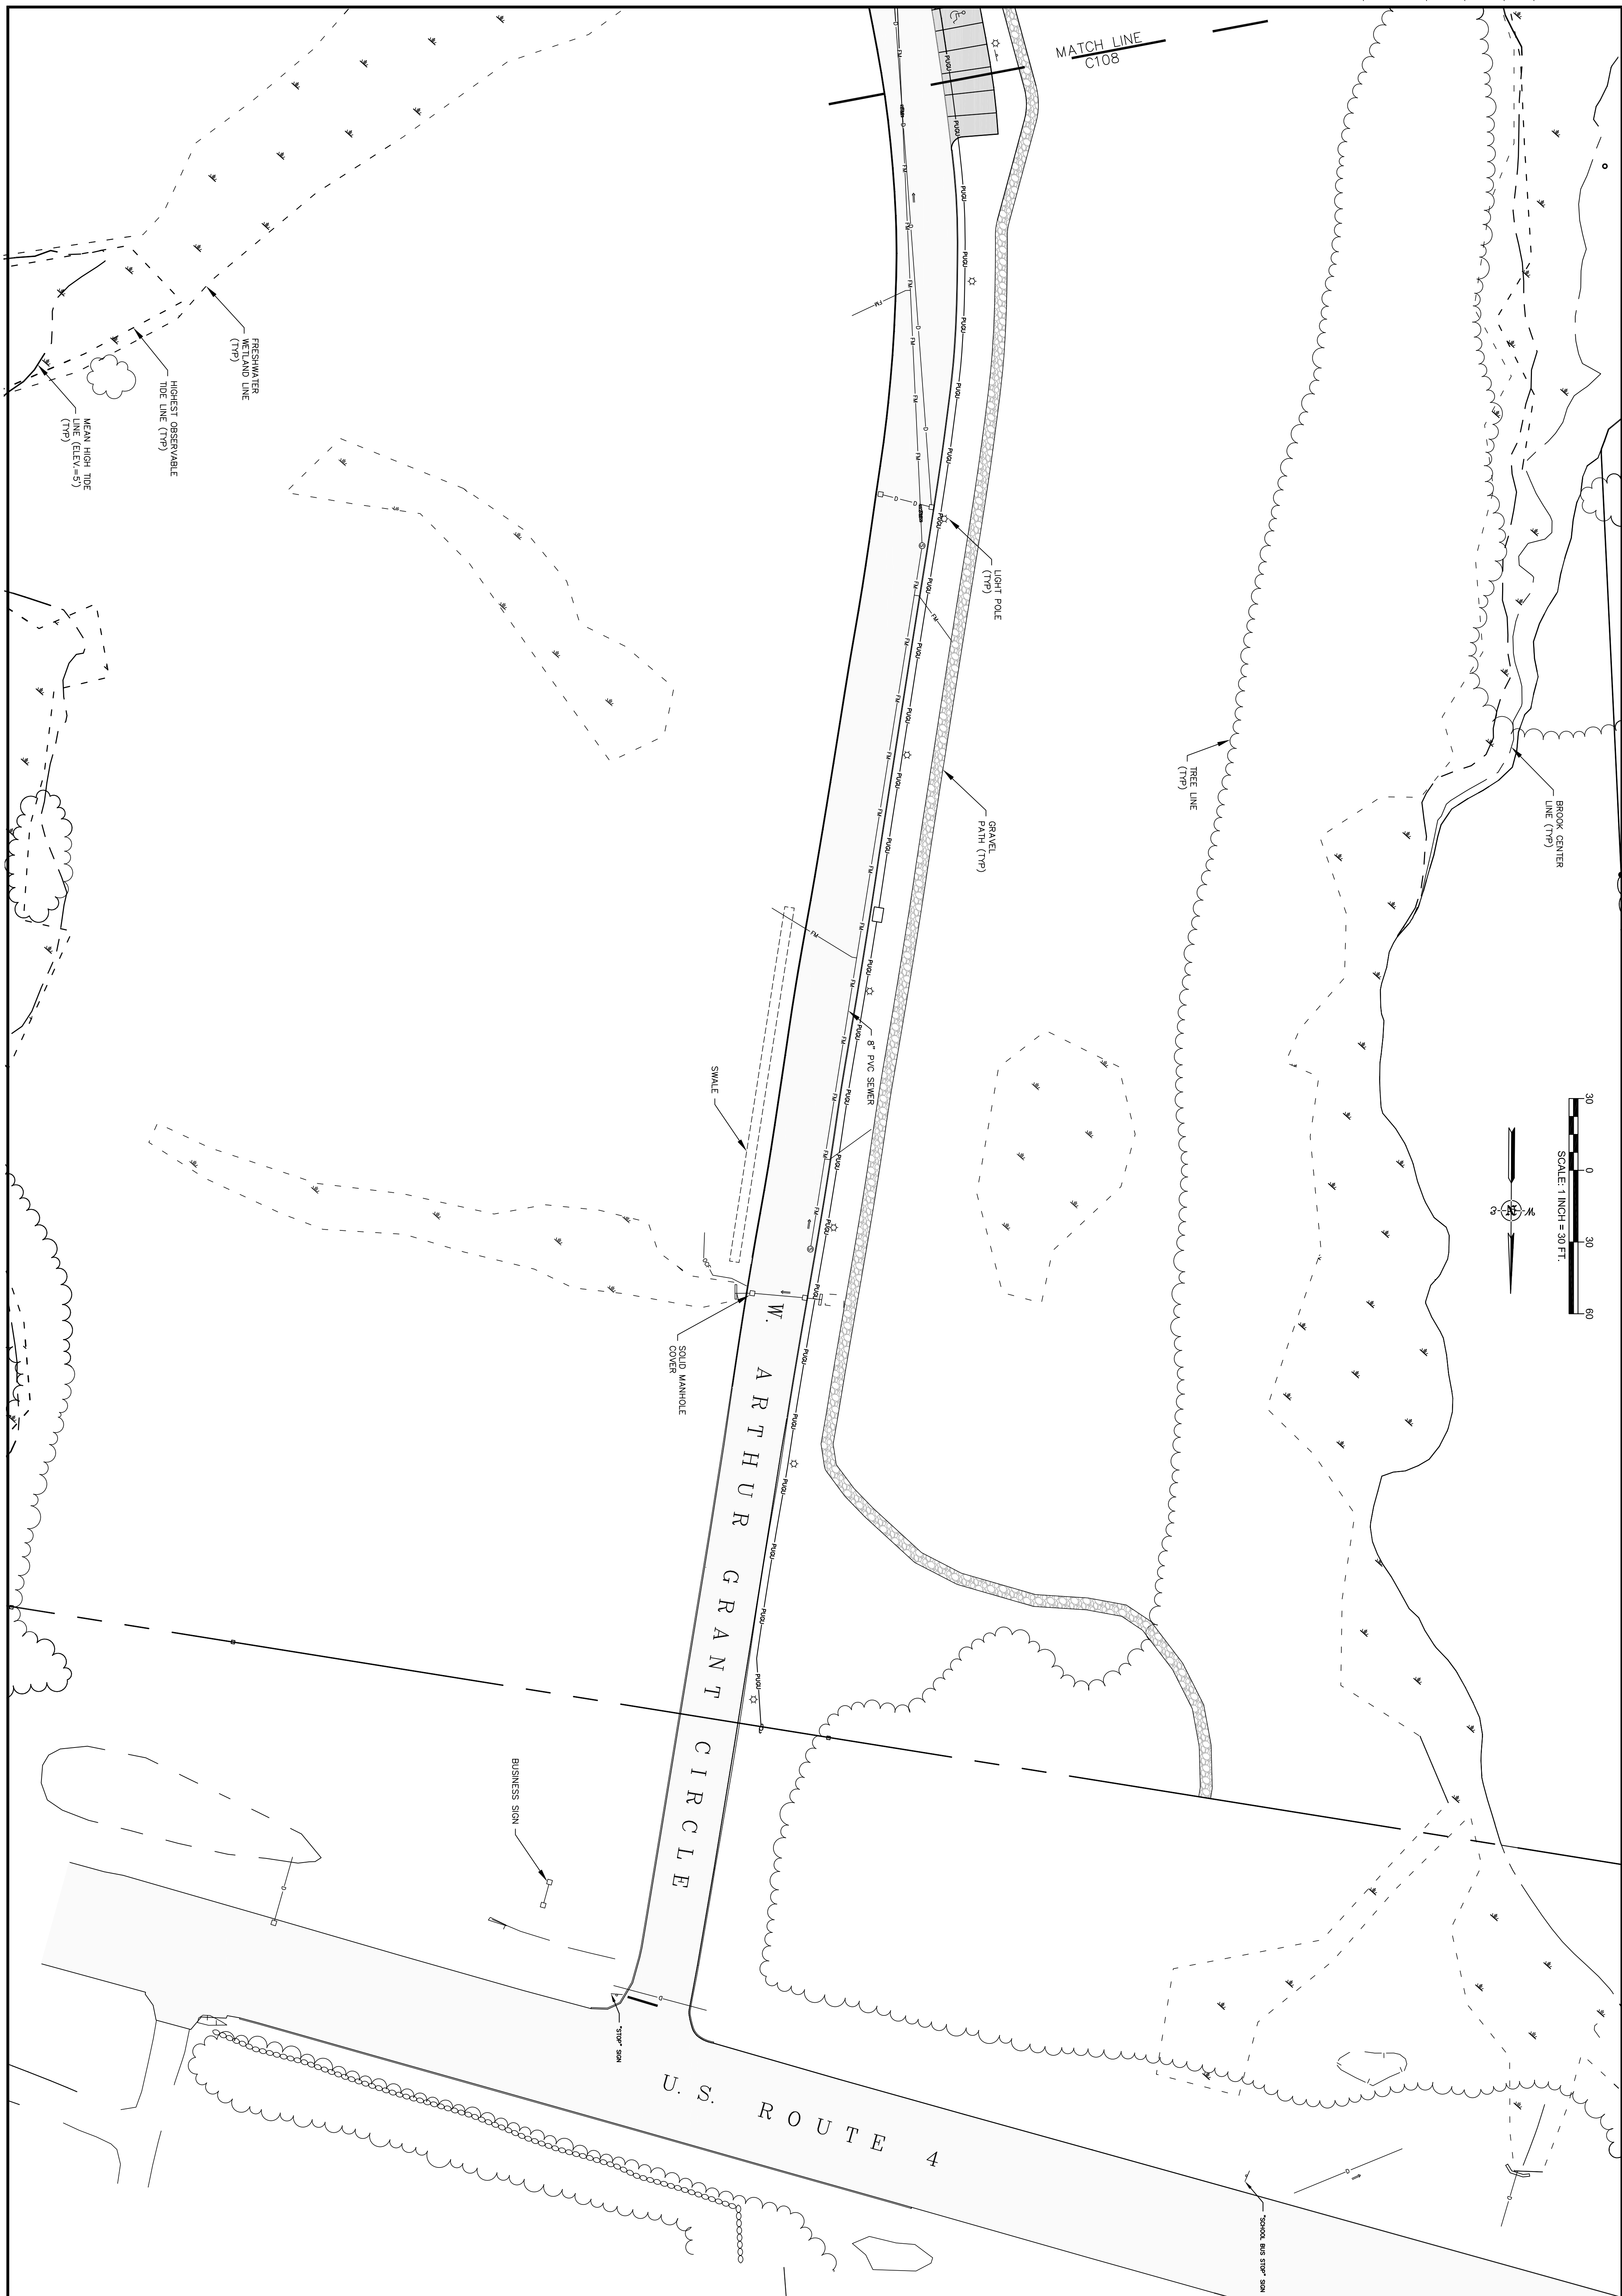

Drawing Name: P:\sproj\15-027\internal\Drawing Files\15-027 CID0 AS BUILT.dwg
Fri, 08 Dec 2017 - 11:48am

0.	FORMAL SUBMISSION	12/1/17	EHK
NO.	REVISIONS	DATE	INT.

SEAL

DATE:	2/10/16
SCALE:	1"=30'
DESIGNED BY:	MS/JLG
DRAWN BY:	JLG
APPROVED BY:	MJS

DWG FILE: _____

AS-BUILT SITE PLAN
prepared for
HARMONY HOMES BY THE BAY
TAX MAP 11, LOTS (27-1)-(27-7)
W. ARTHUR GRANT CIRCLE DURHAM, NH



JOB: 15-027

777