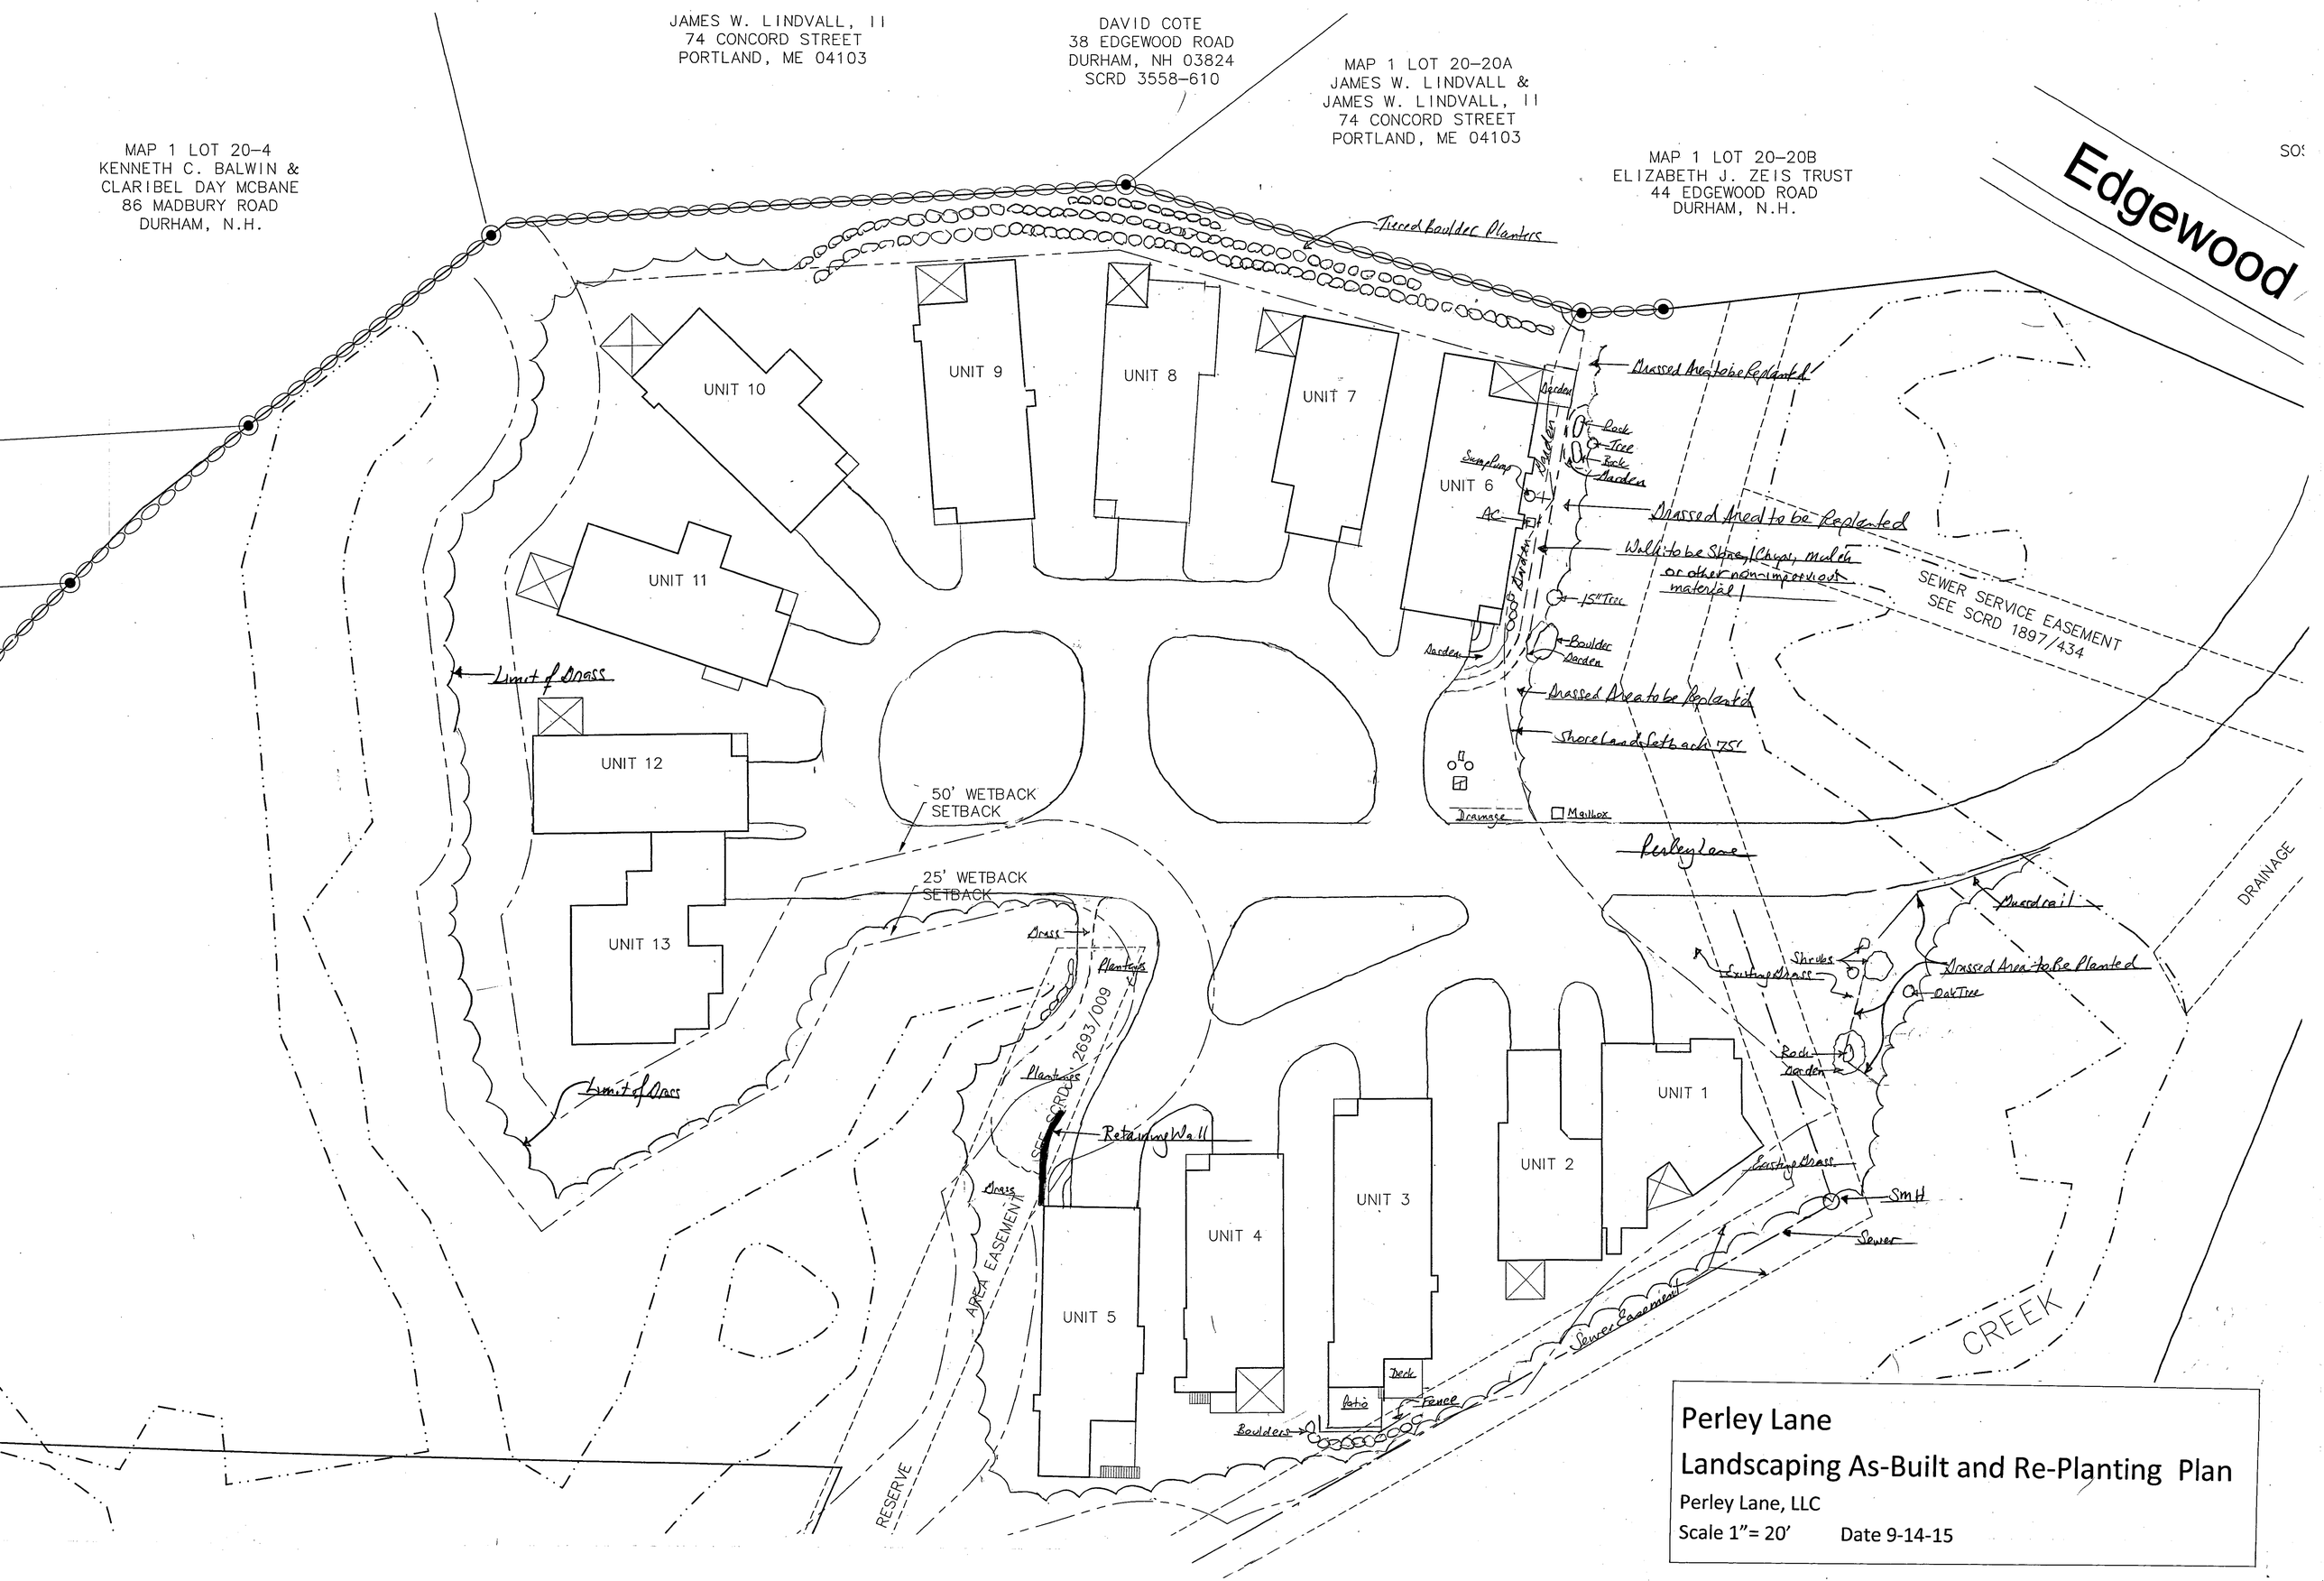

Perley Lane

Landscaping As-Built and Re-Planting Plan

Perley Lane, LLC

Scale 1"= 20' Date 9-14-15